
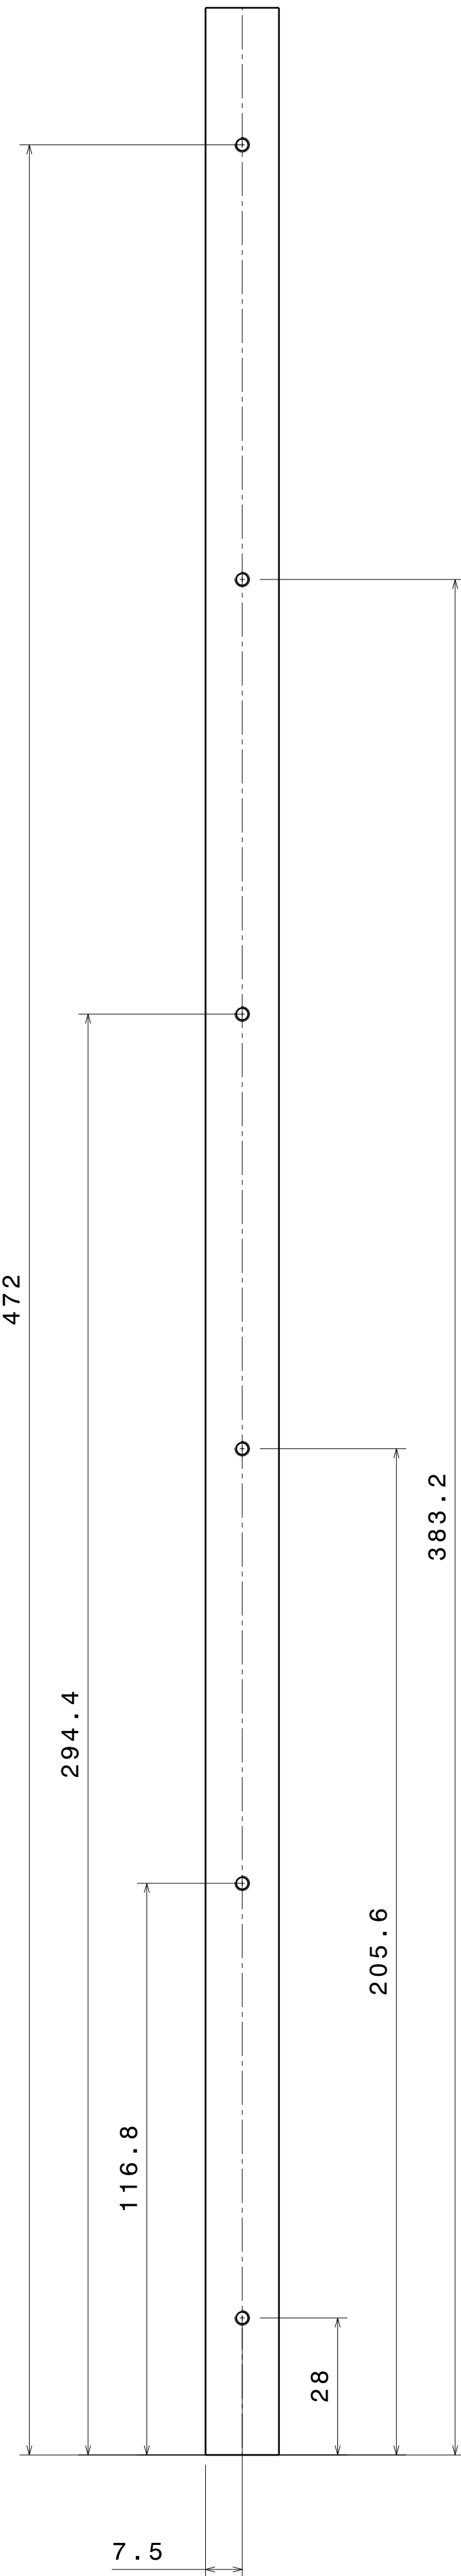


Section view A-A
Scale: 1:1

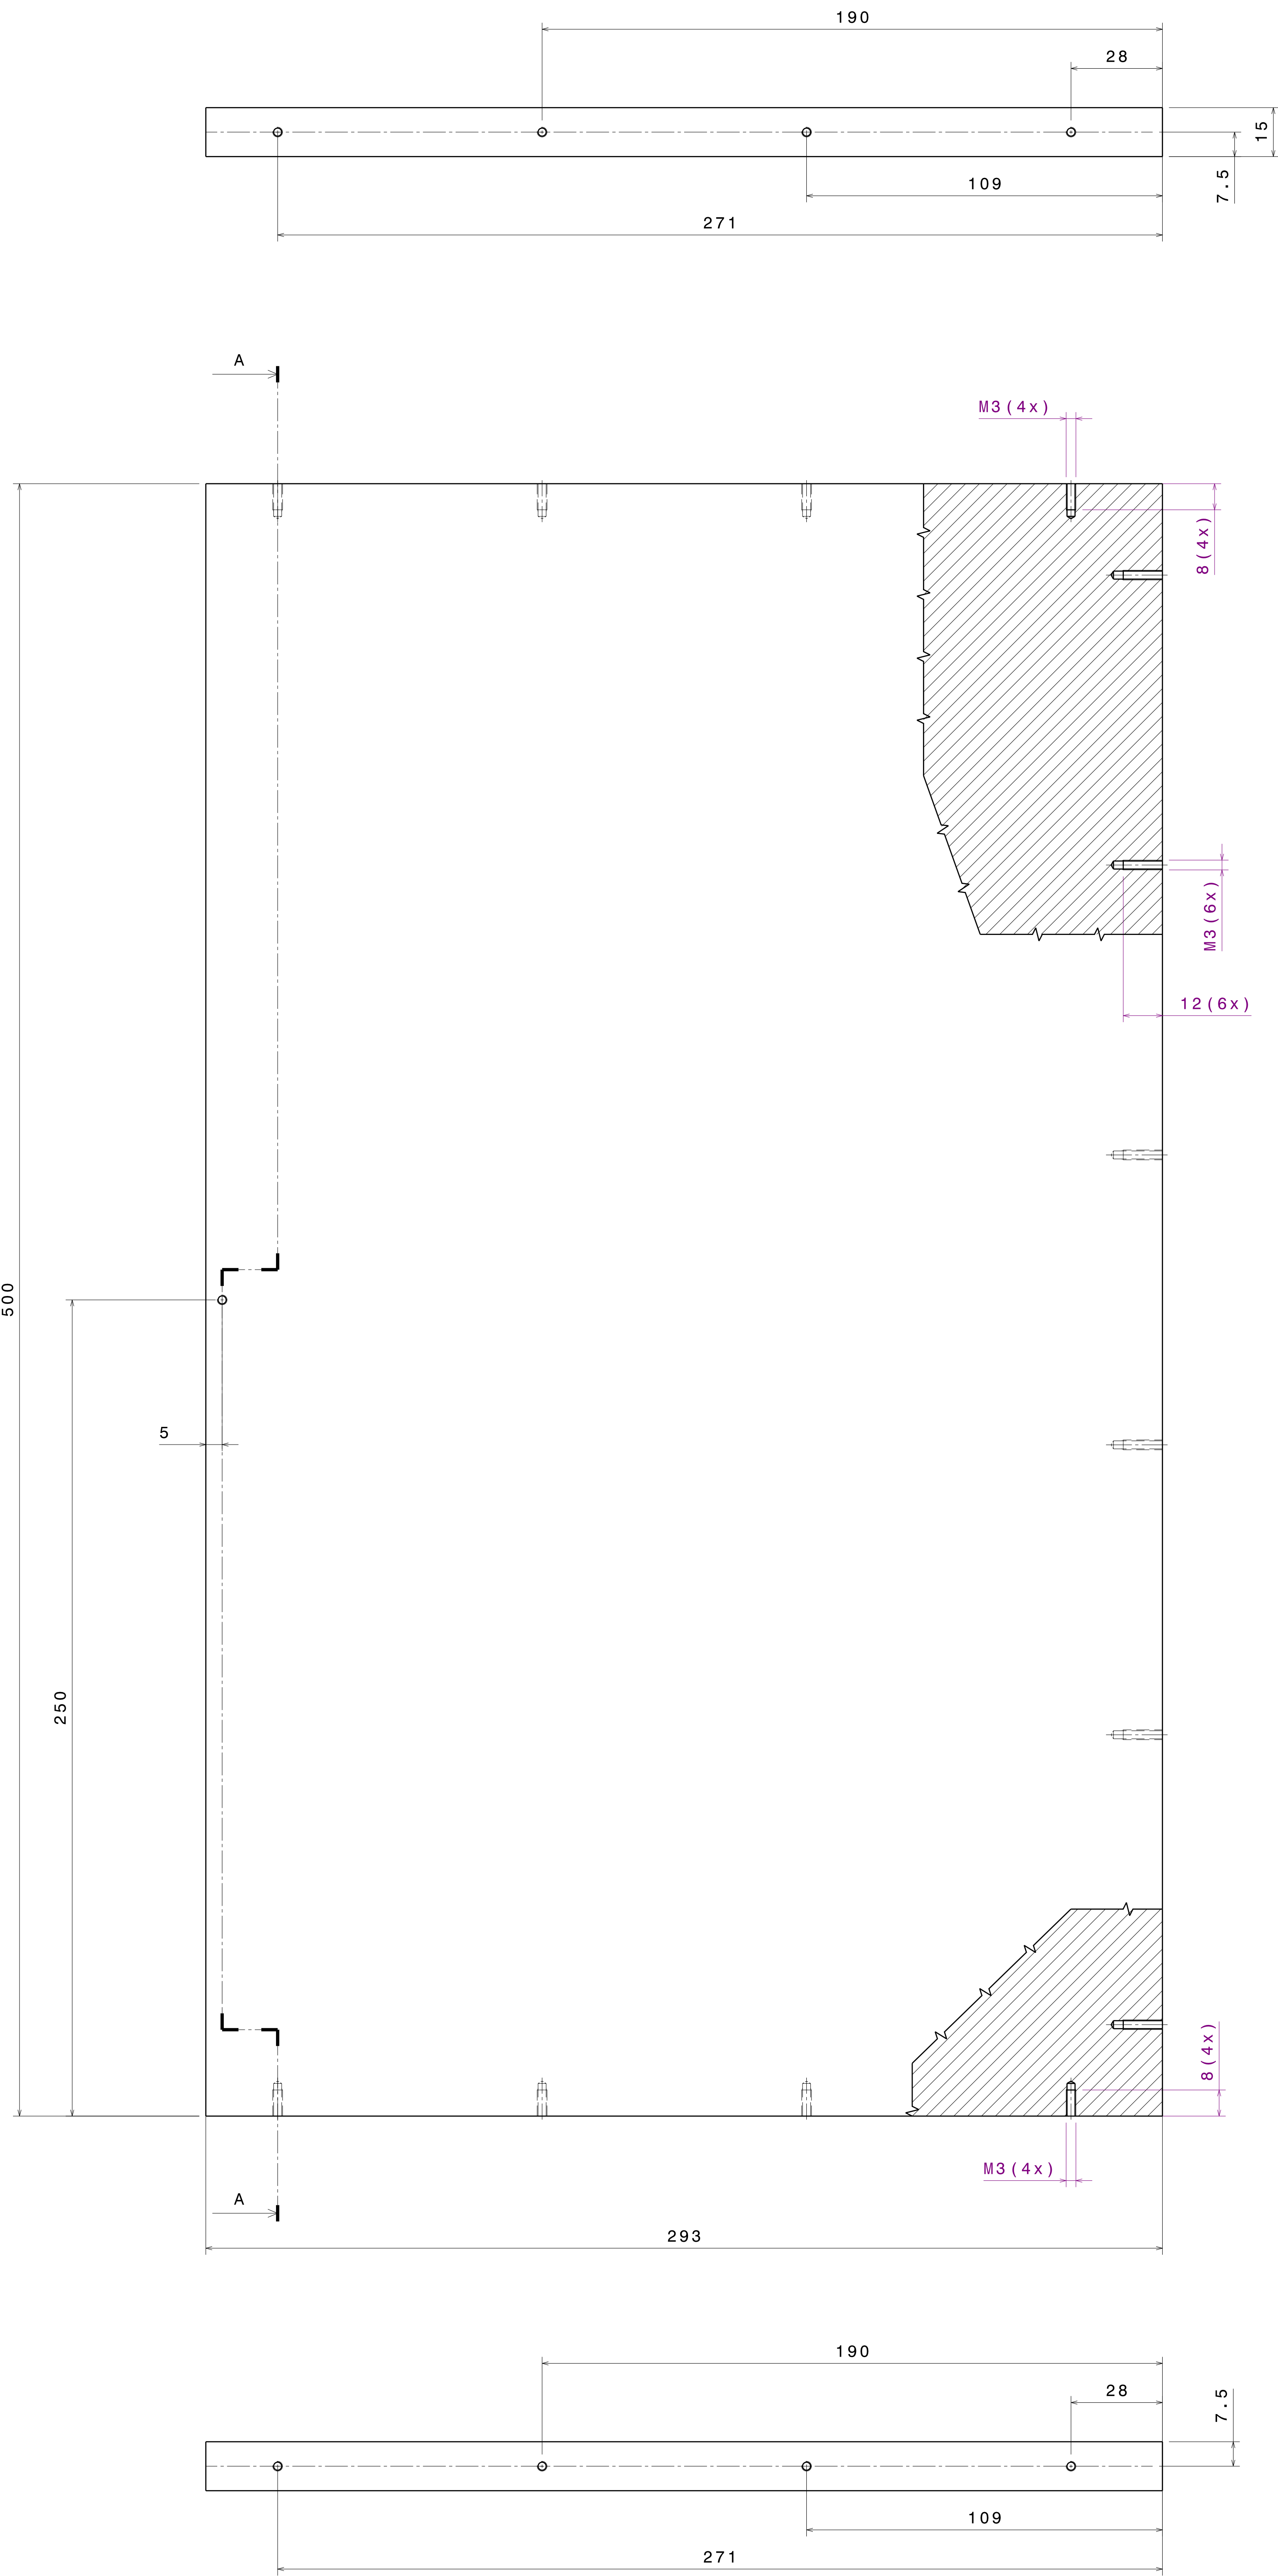

AS BUILT

| | | | |
|---|--|-------------------------------|--|
| General tolerances unless otherwise stated according to ISO 2768-mS | | Material: PVC (Black) | |
| Library: Large Spark Chamber | | Date: 10/02/2019 | |
| Project: R&D Spark Chamber | | Revision: A | |
| Name: Endplate Housing | | Item number: AA0253 | |
| Released | | Released | |
| National Institute for Subatomic Physics | | Nikhef number: 40091-ME-00142 | |