
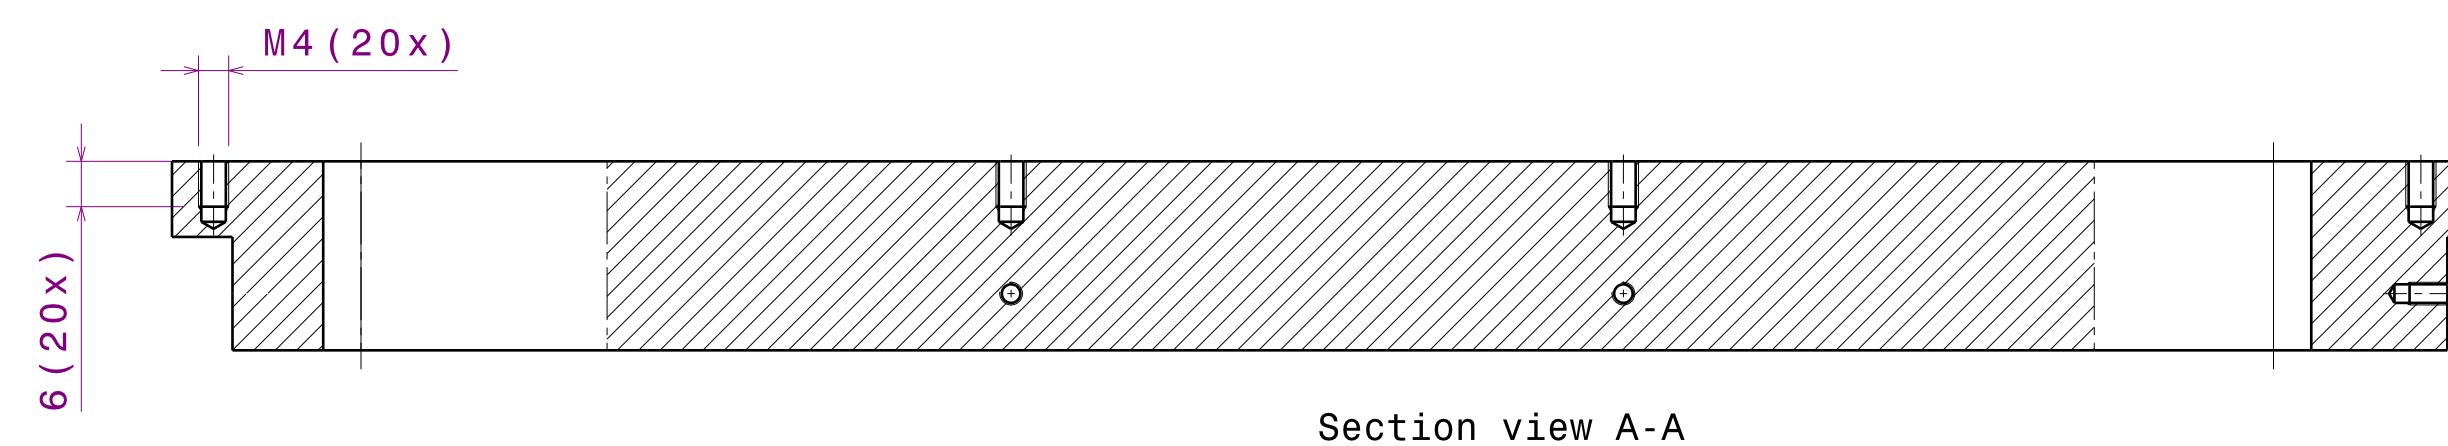
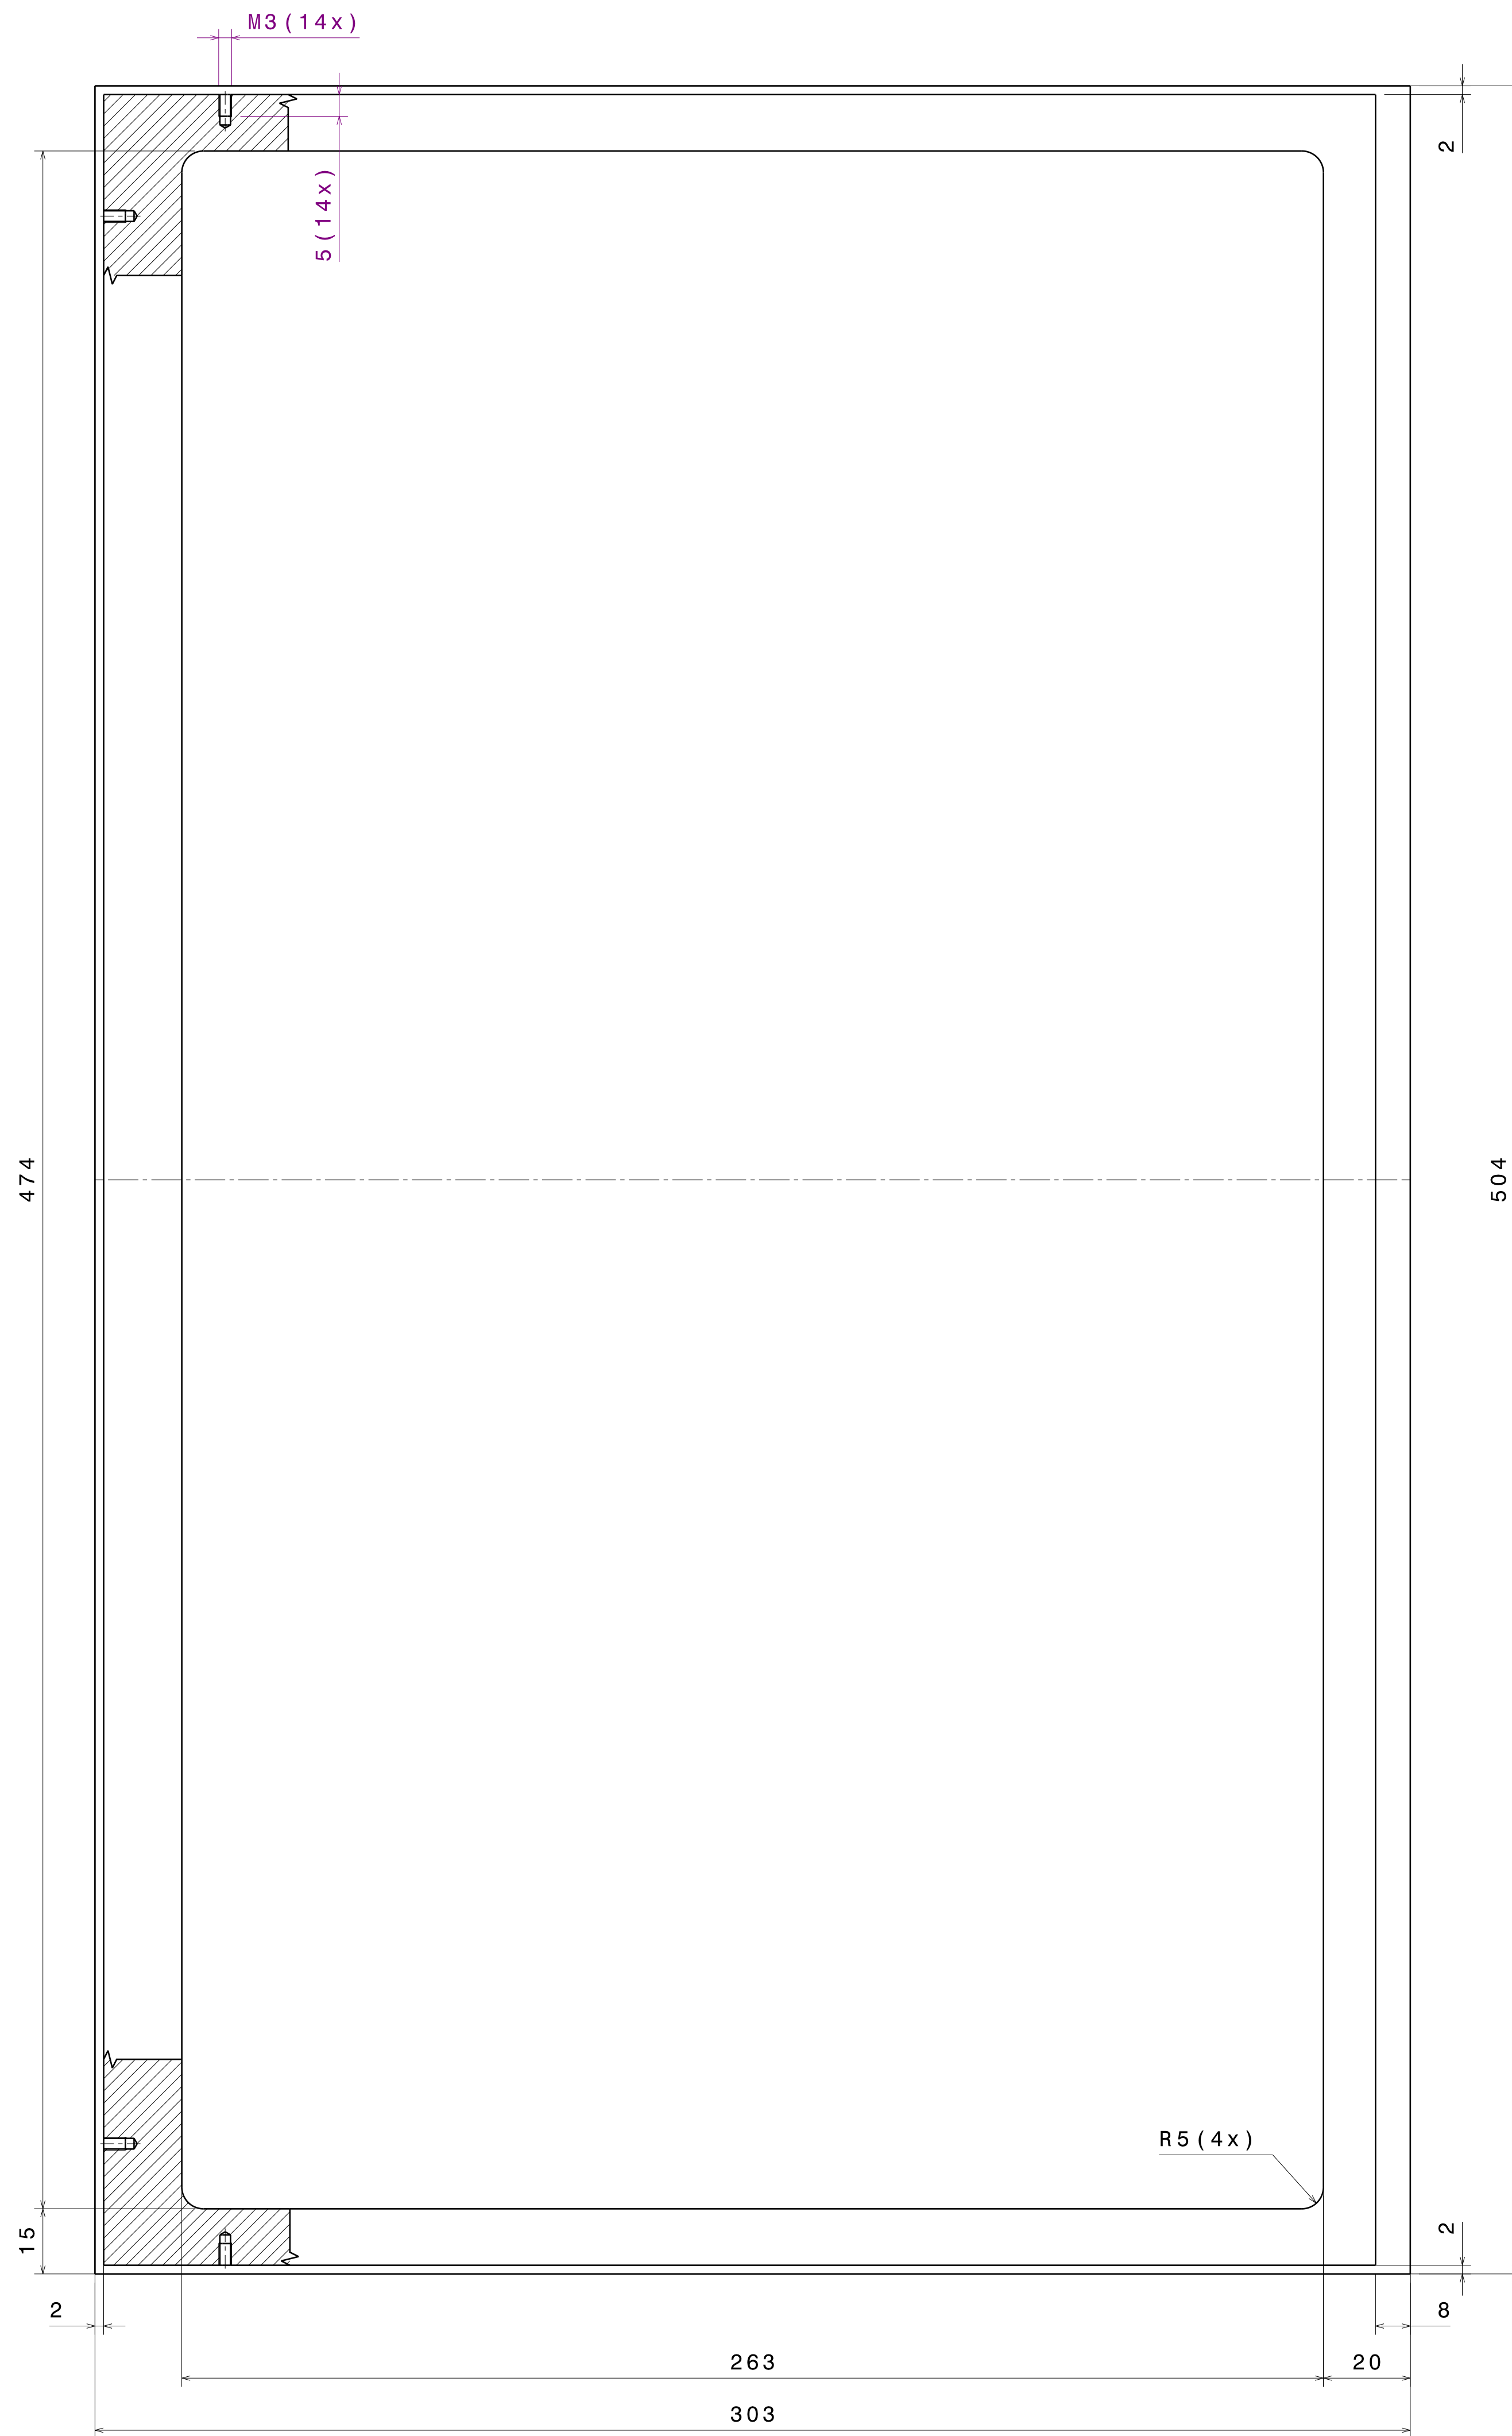
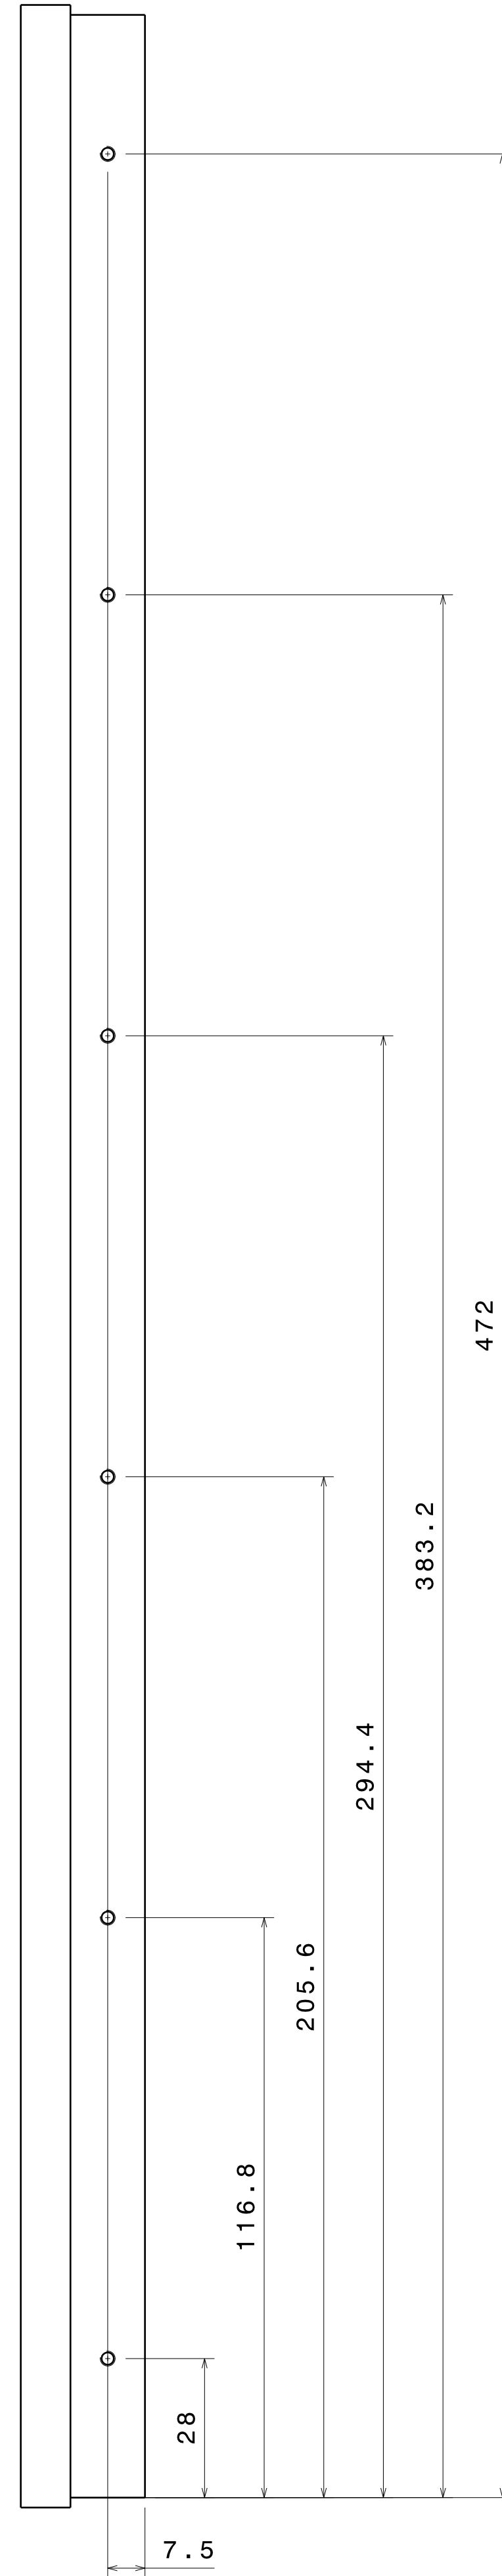
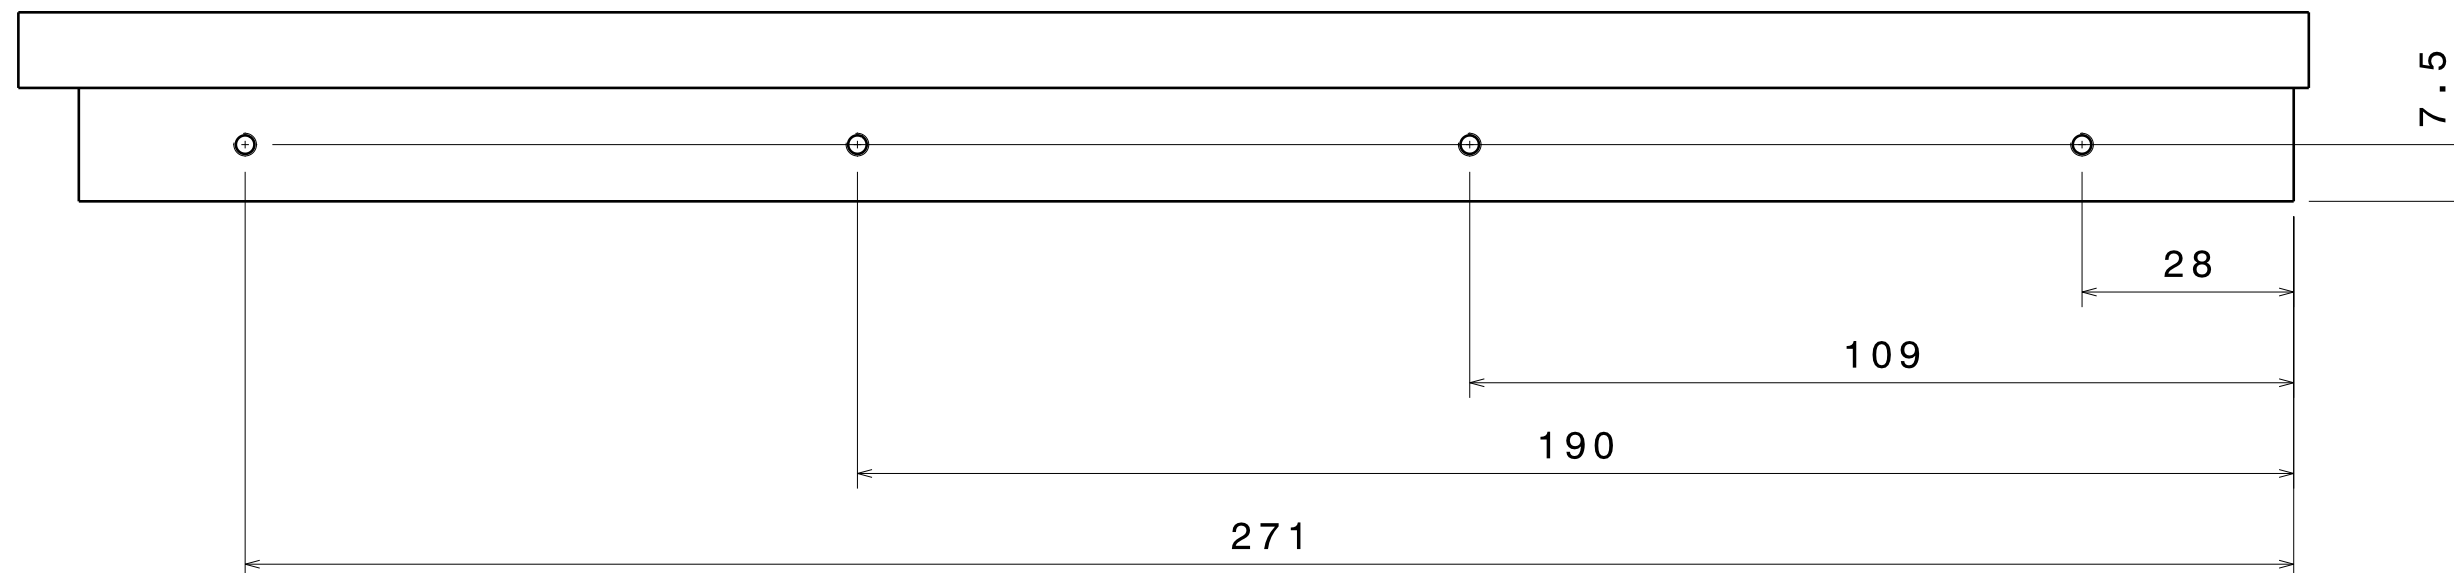
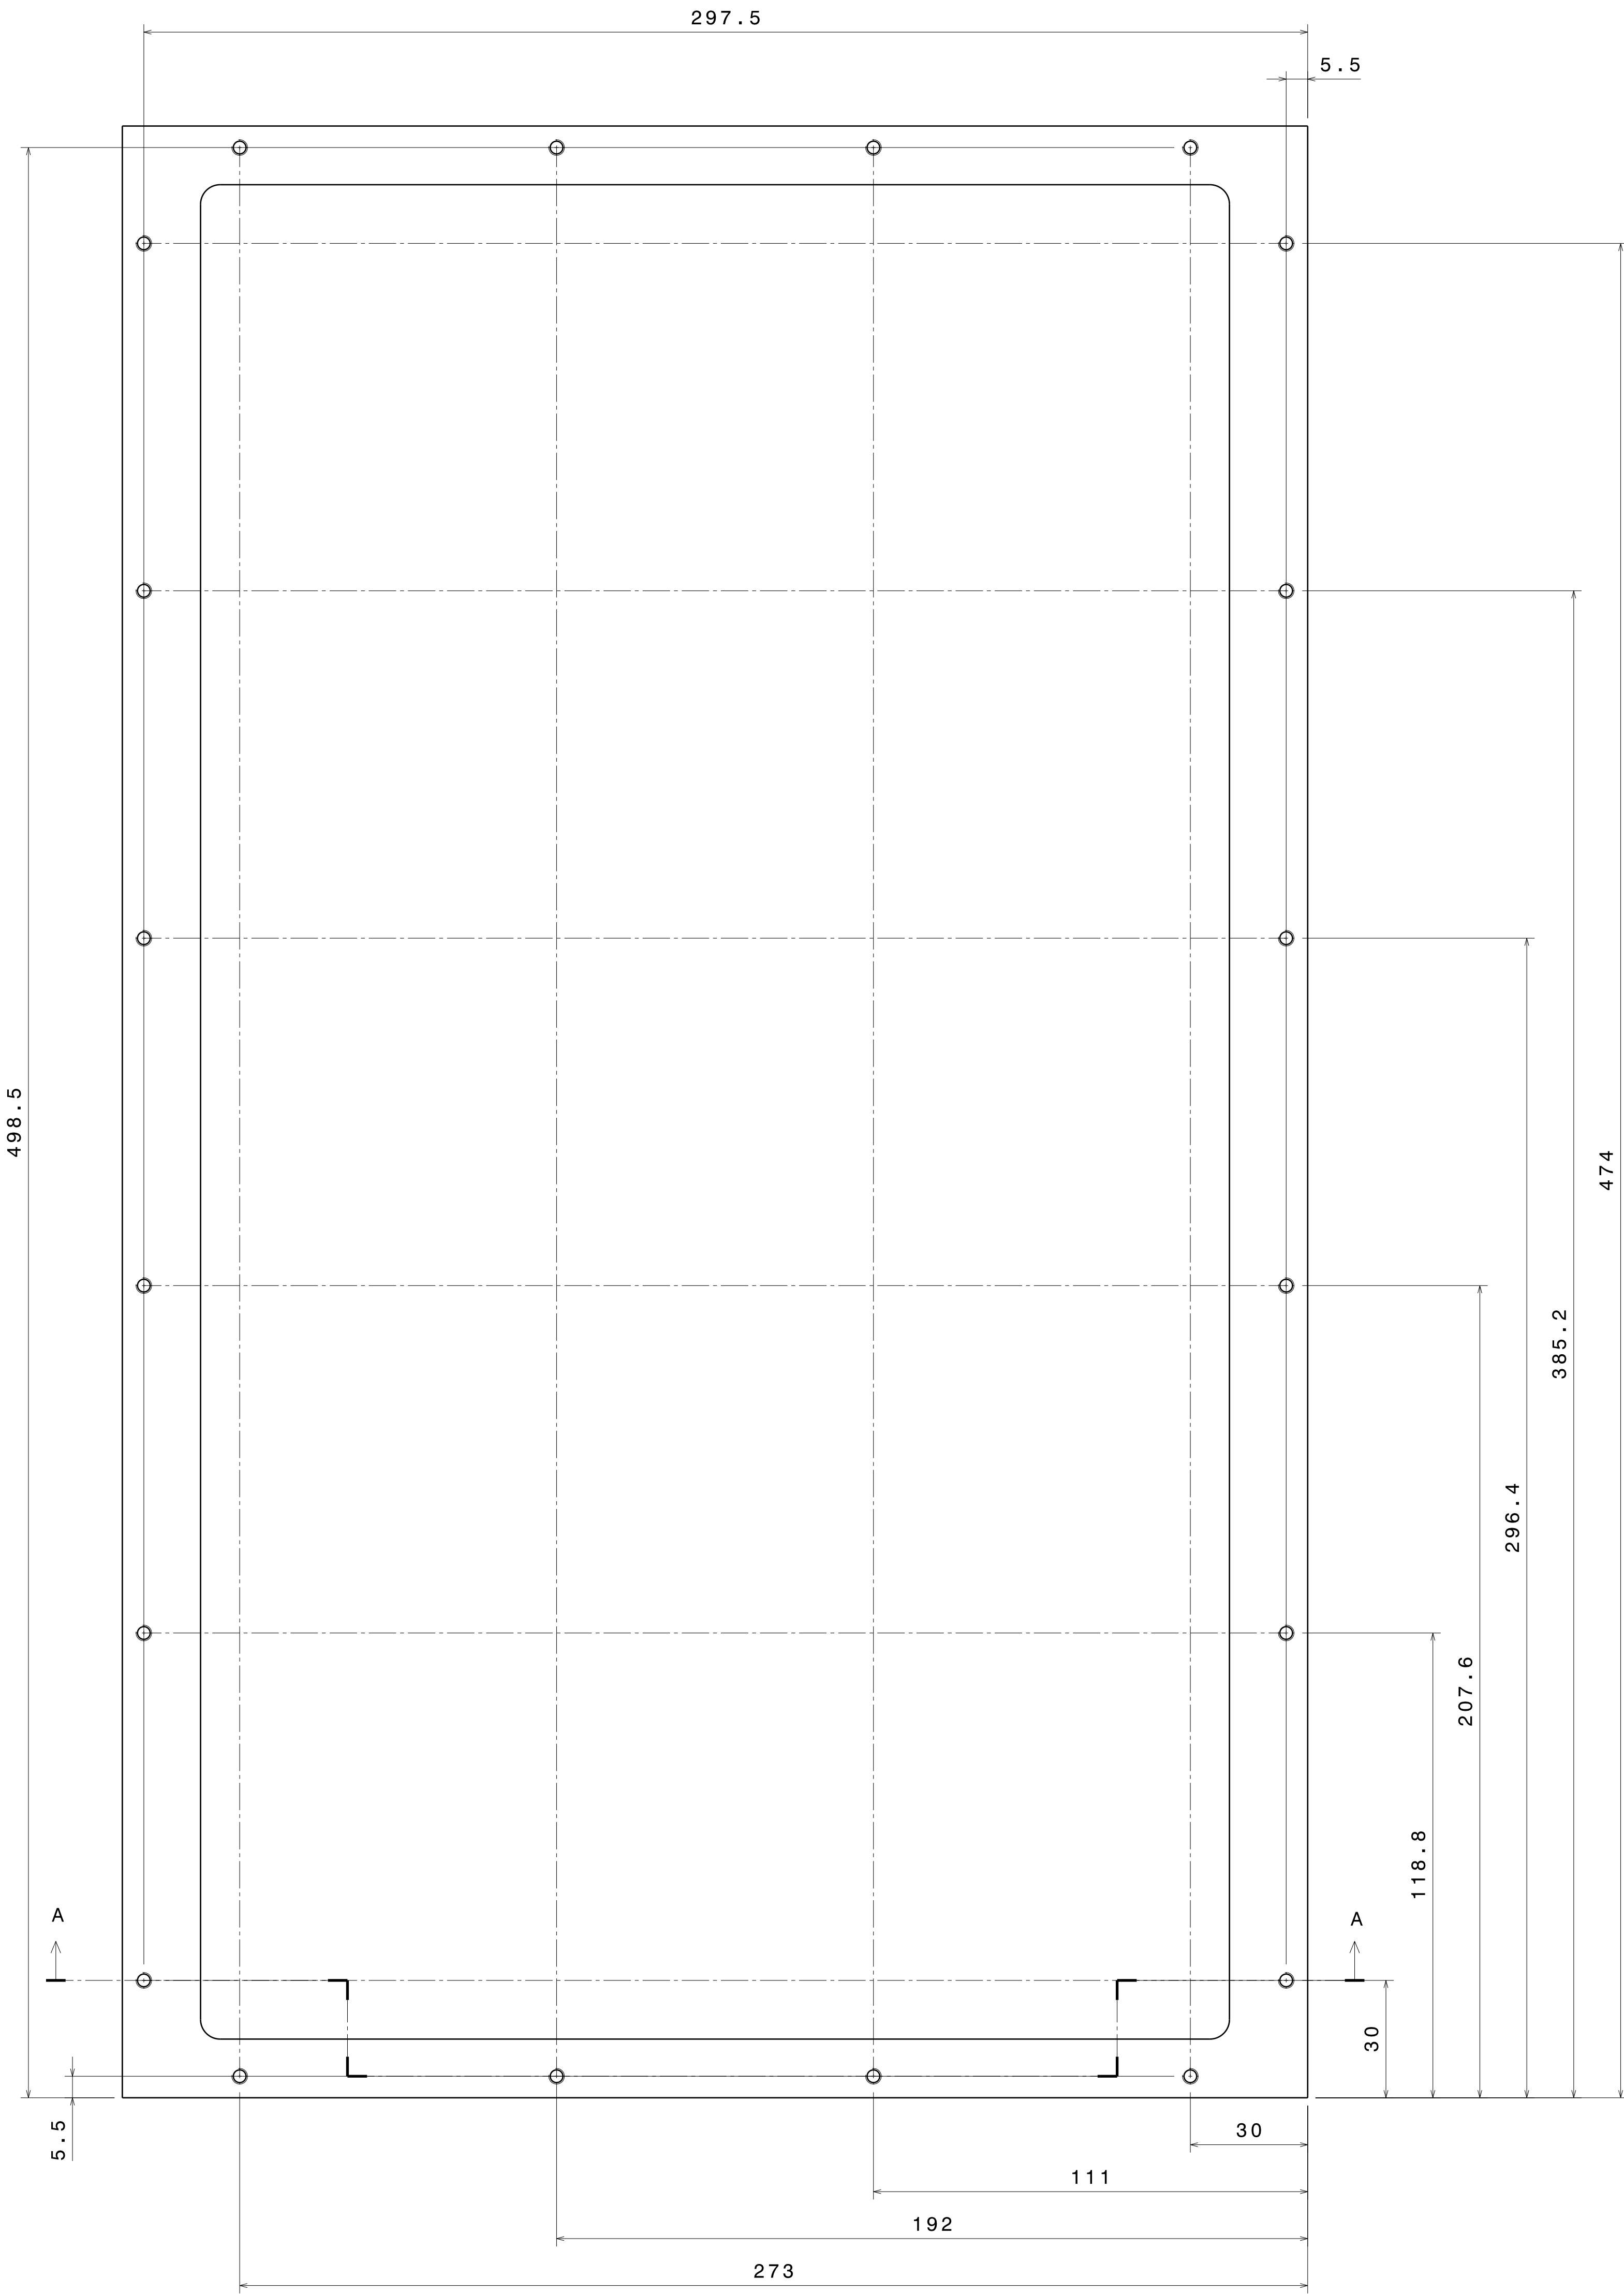


Top view

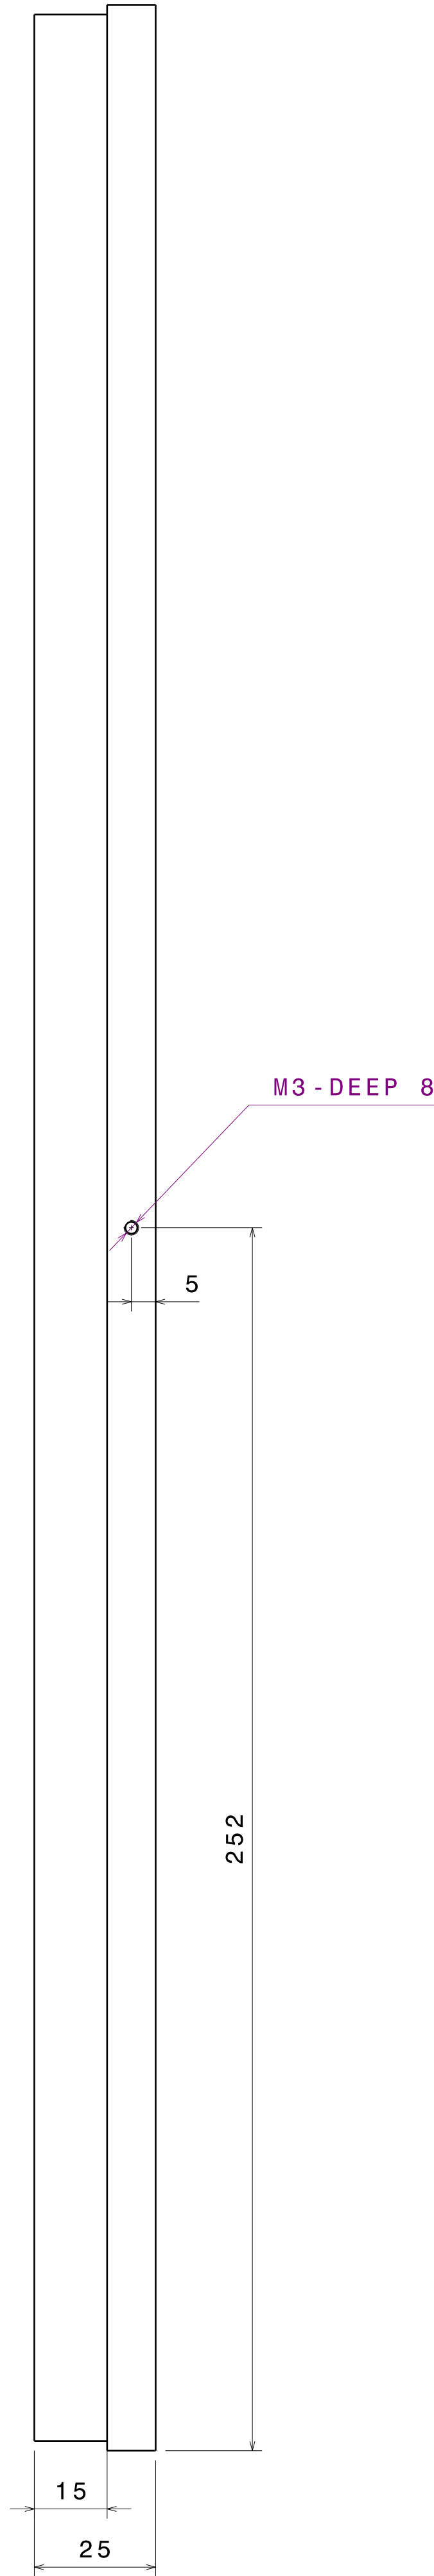

Section view A-A

AS BUILT

General tolerances unless otherwise stated according to ISO 2768-mS		Material: PVC (Black)	
Geometrical tolerances unless otherwise stated according to ISO 1101		Date: 15/10/2019	
Degrees unless otherwise stated according to ISO 1035		Revision: A	
Project: R&D Spark Chamber		Drawn: AD	Engineered: A. Korperaal
Top folder: Large Spark Chamber		Checked: A. Korperaal	Released: A. Korperaal
Name:		Item number:	Item number:
End Flange Housing		AA0246	Released
National Institute for Subatomic Physics		Nikhef number: 40091-ME-00547	
Nikhef		Nikhef	
This drawing may not be used for commercial purposes without written authorization.			