


Section view A-A



AS BUILT

General tolerances unless otherwise stated according to :ISO-2768-mK-E
Geometrical tolerances unless otherwise stated according to:ISO-8015-E
Roughness unless otherwise stated according to :ISO-1302

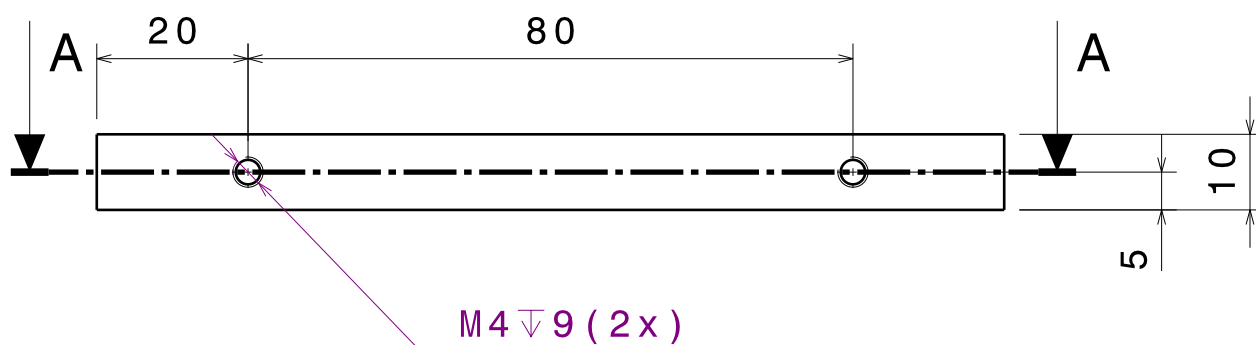

Material: PVC (Color ?)

Project: R&D Spark Chamber

Units: mm

Date: 15/02/2010


Revision: A

Library: Large Spark Chamber

Size: A4

Engineer: A. Korpelaar

Name: Upper Turnplate 1

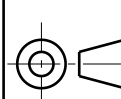


Checked: A. Korpelaar

Item number: AA0269

Status: Released



National Institute for
Subatomic Physics
Science Park 105, 1098XG Amsterdam

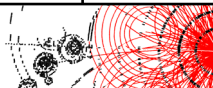

Nikhef number:
40091-ME-00180