 



Top view
Scale: 2:5




Front view
Scale: 2:5

A
A

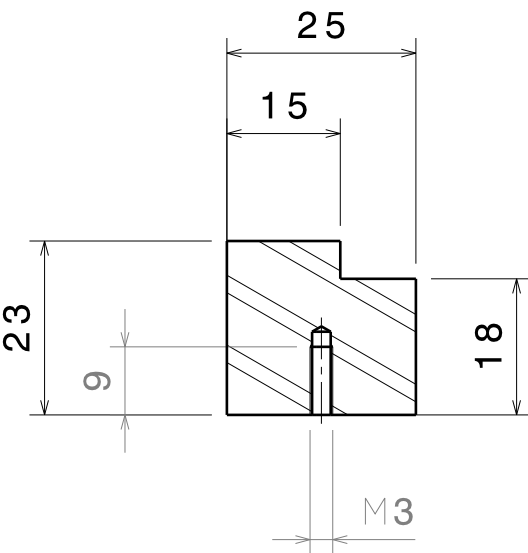


Section view A-A
Scale: 1:1

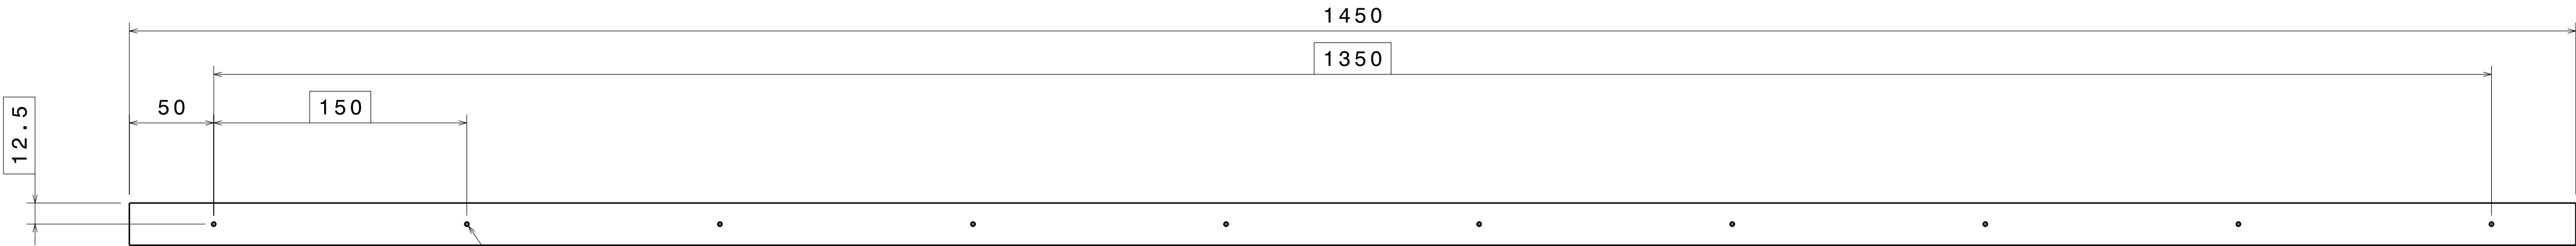

(10x)
⊕ ⌀ 0.4

Bottom view
Scale: 2:5

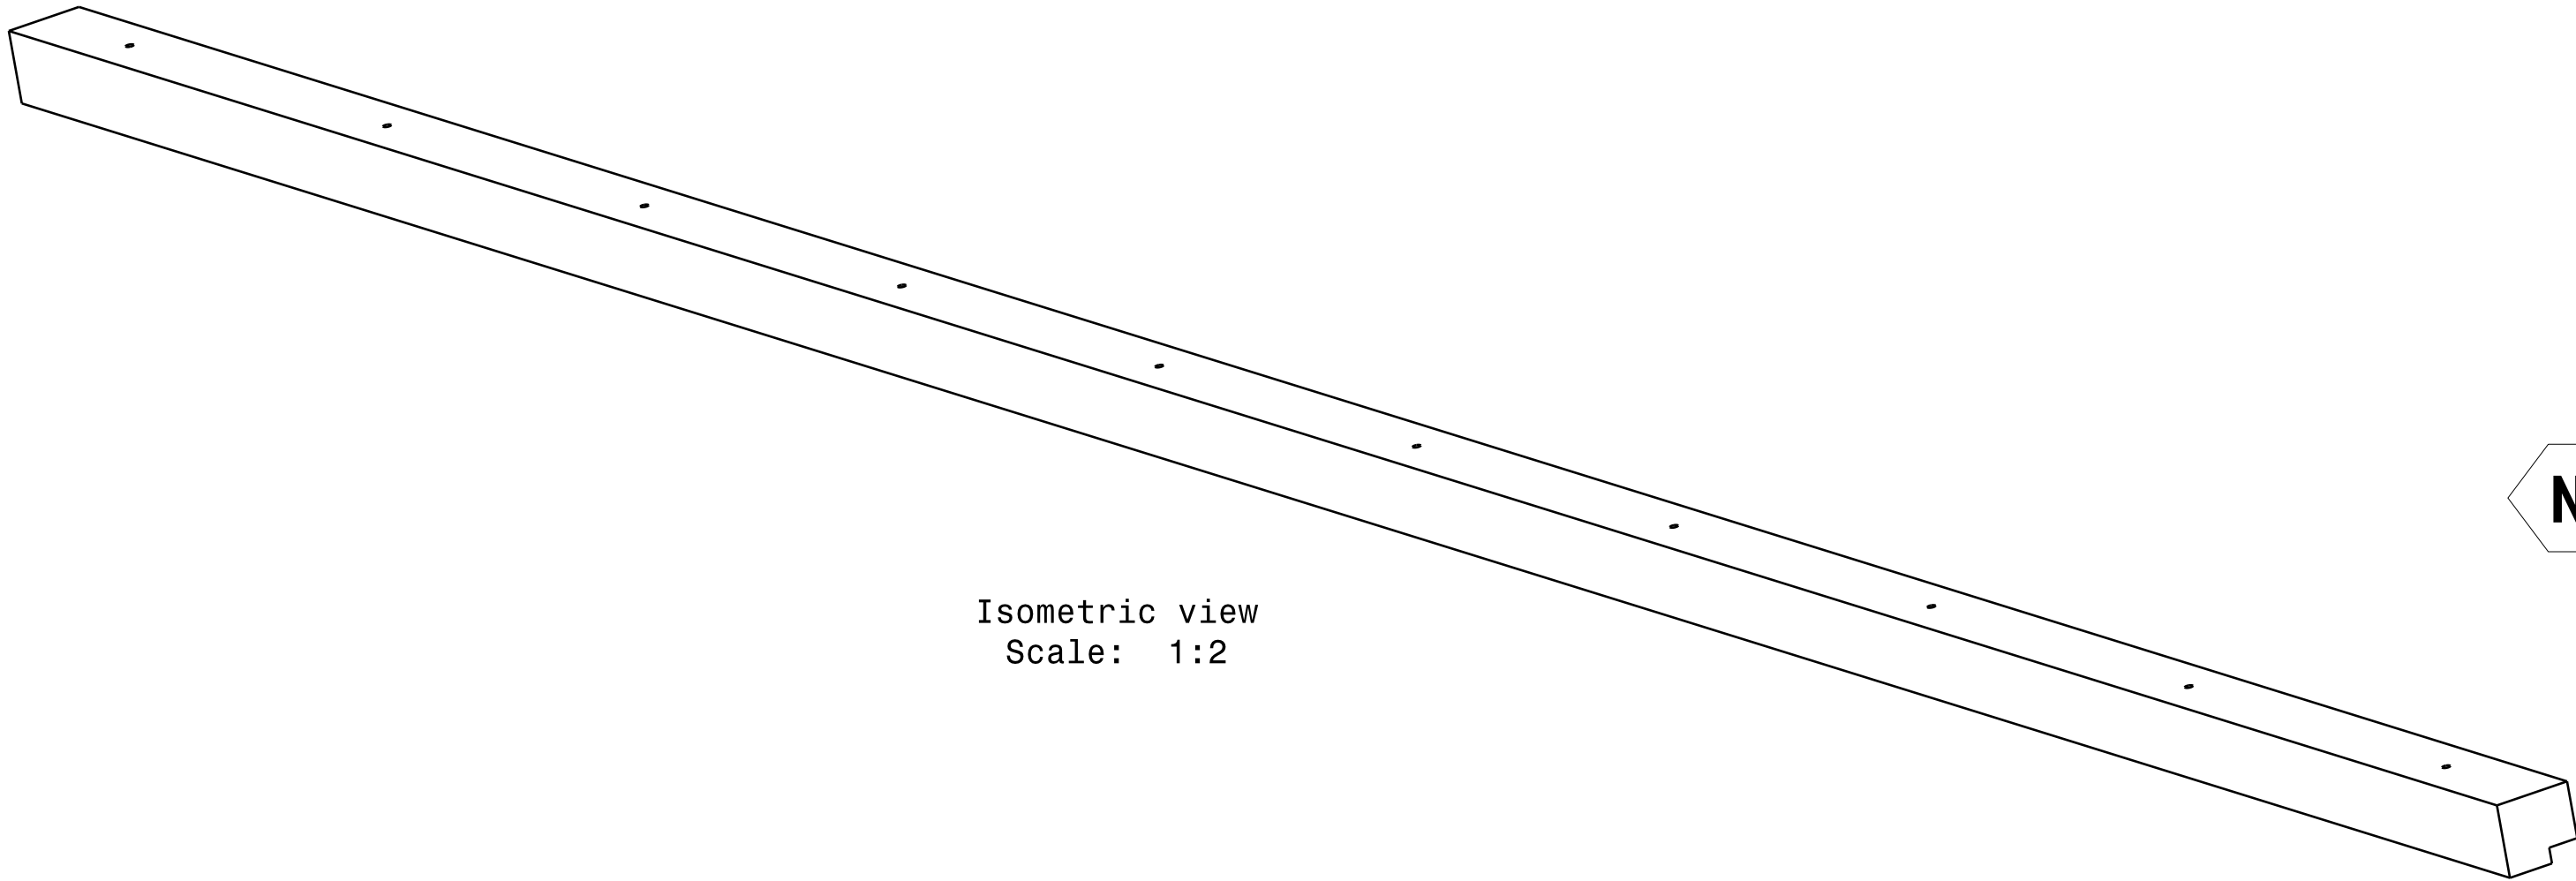

Isometric view
Scale: 1:2

Note: Part black anodised

AS BUILT

General tolerances unless otherwise stated according to :ISO-2768-MK-E Geometrical tolerances unless otherwise stated according to:ISO-8015-E Roughness unless otherwise stated according to :ISO-1302			Material: Aluminium	
Project: R&D Spark Chamber		Units: mm	Date: 10/02/2010	Revision: A
Library: Large Spark Chamber		Size: A1	Engineer: A. Korporaal	
Name: Front Strip Large			Checked: A. Korporaal	
			Item number: AA0258	Status: Released
National Institute for Subatomic Physics Science Park 106, 1098BG Amsterdam				
		Nikhnev number: 40091-ME-00156		
This drawing may not be used for commercial purposes without written authorisation.				