



Top view  
Scale: 1:2

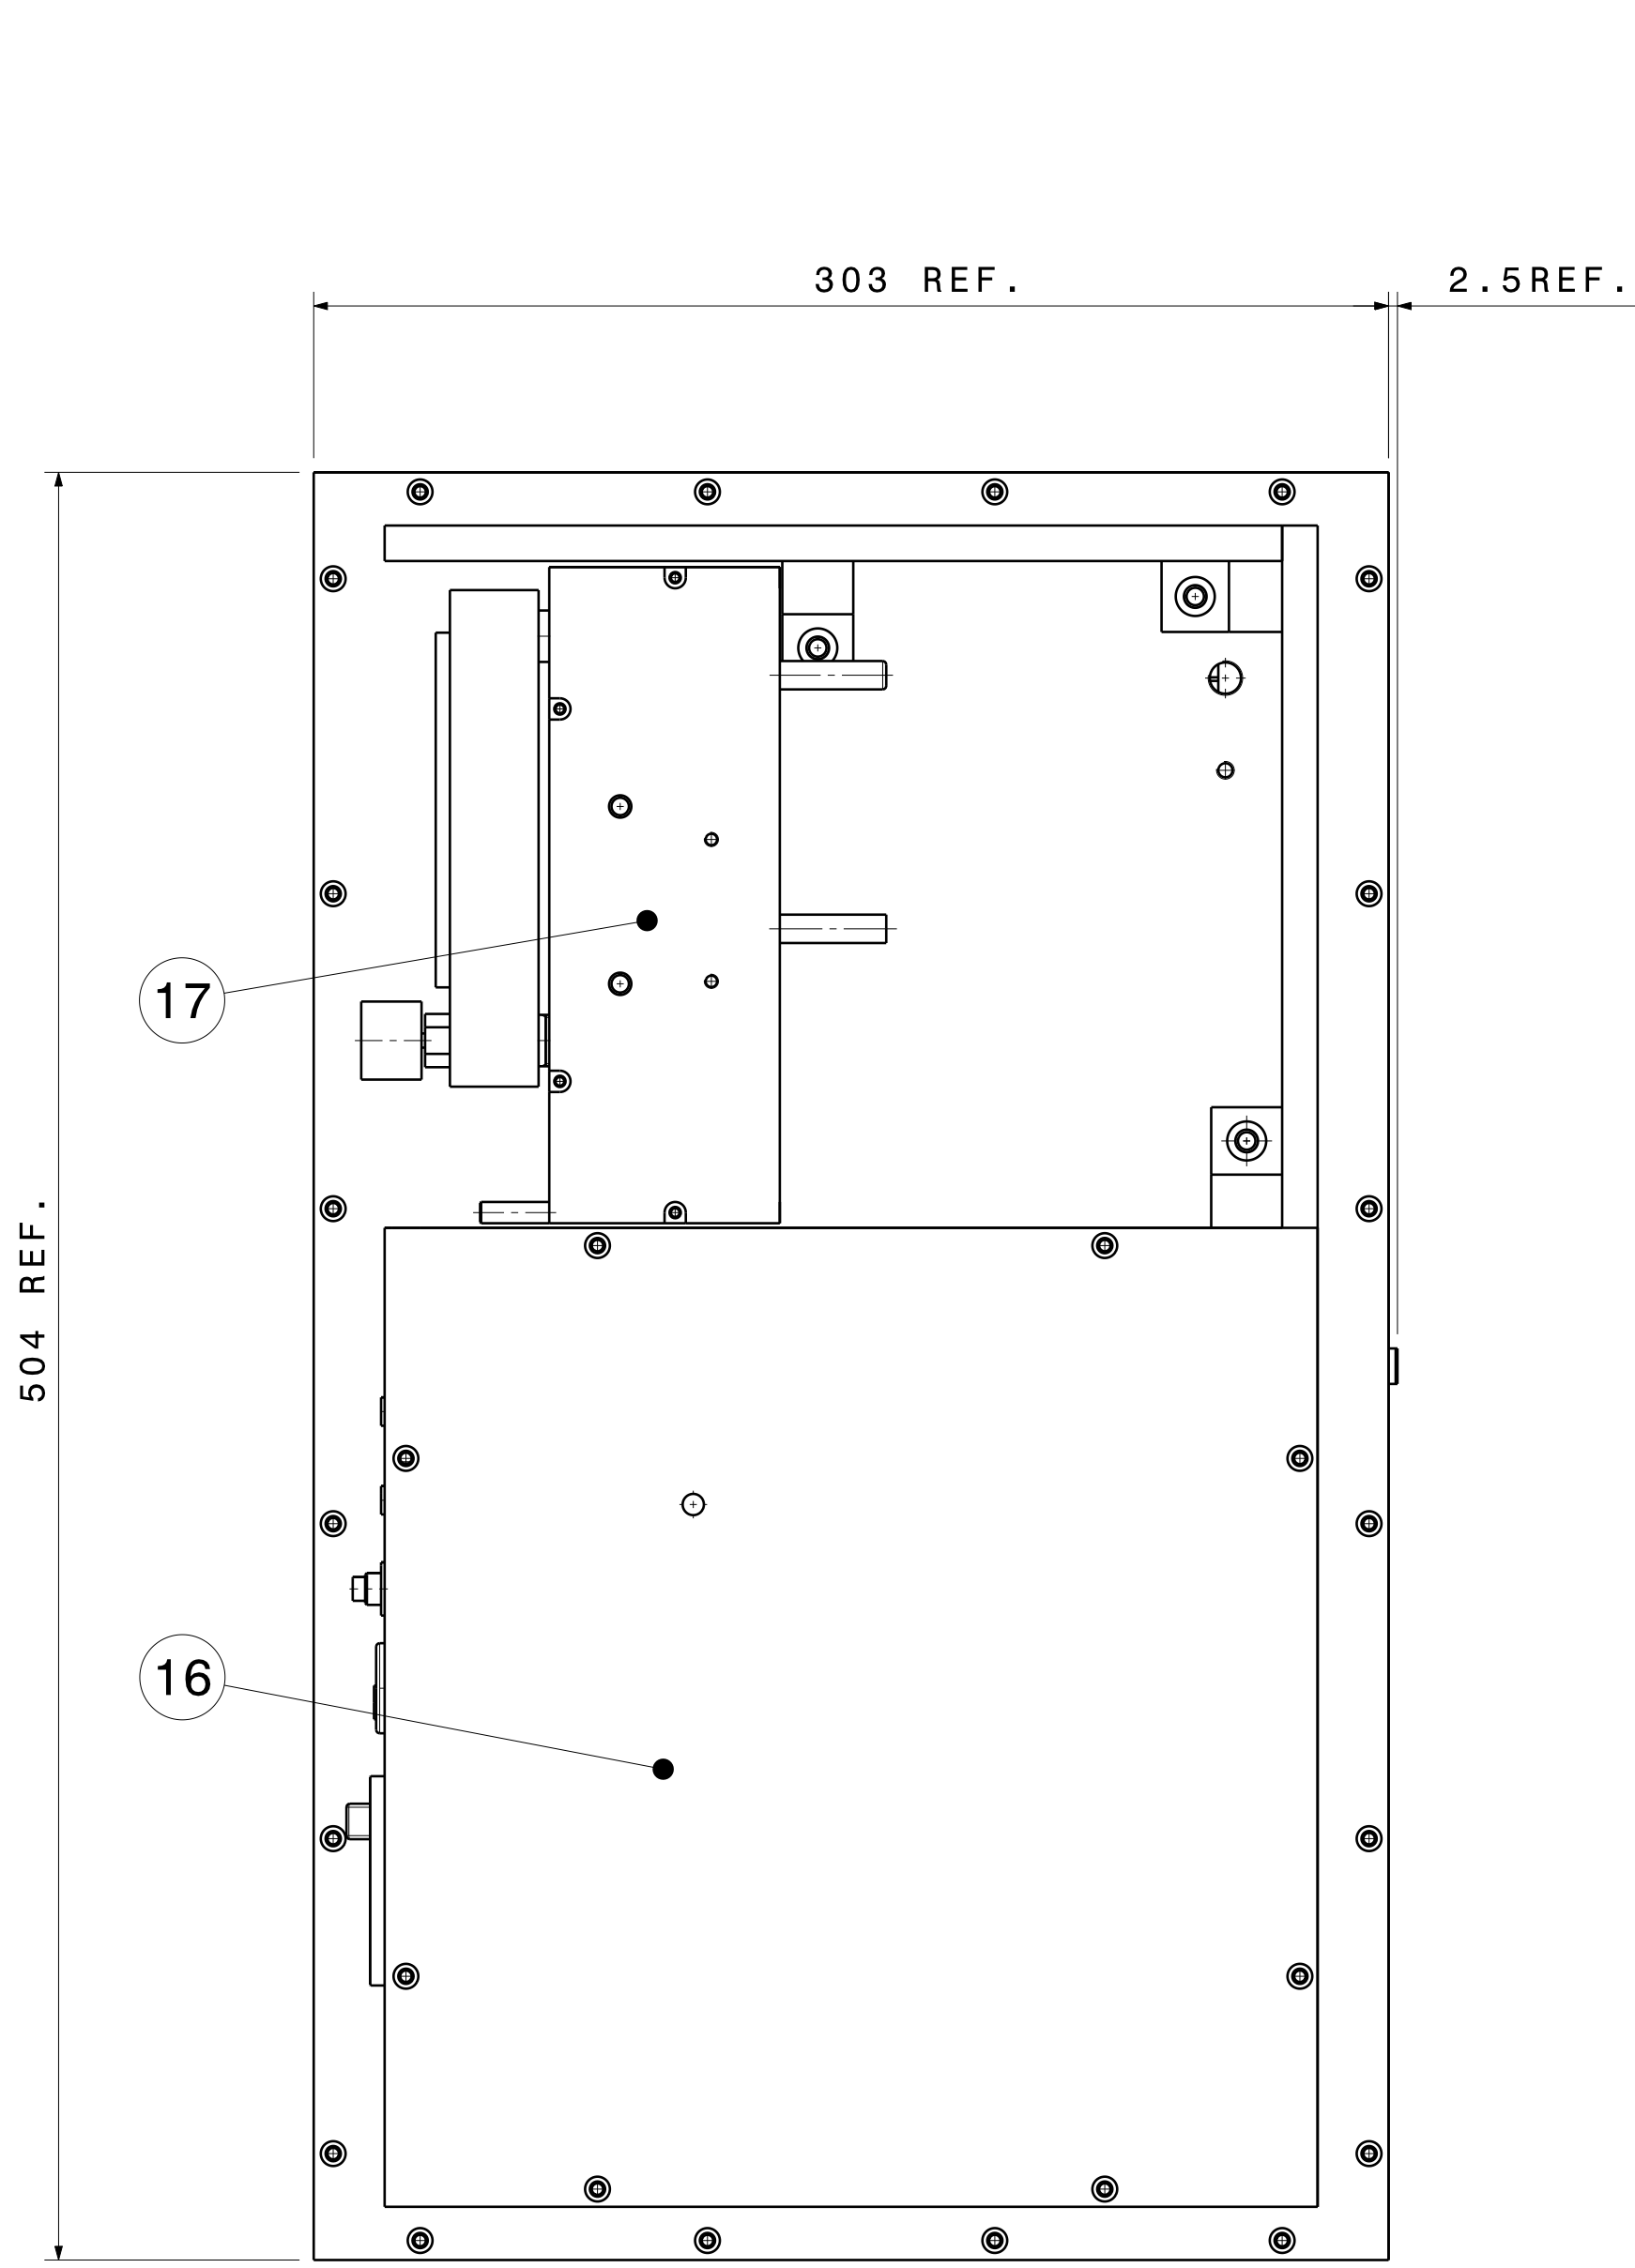

Left view  
Scale: 1:2

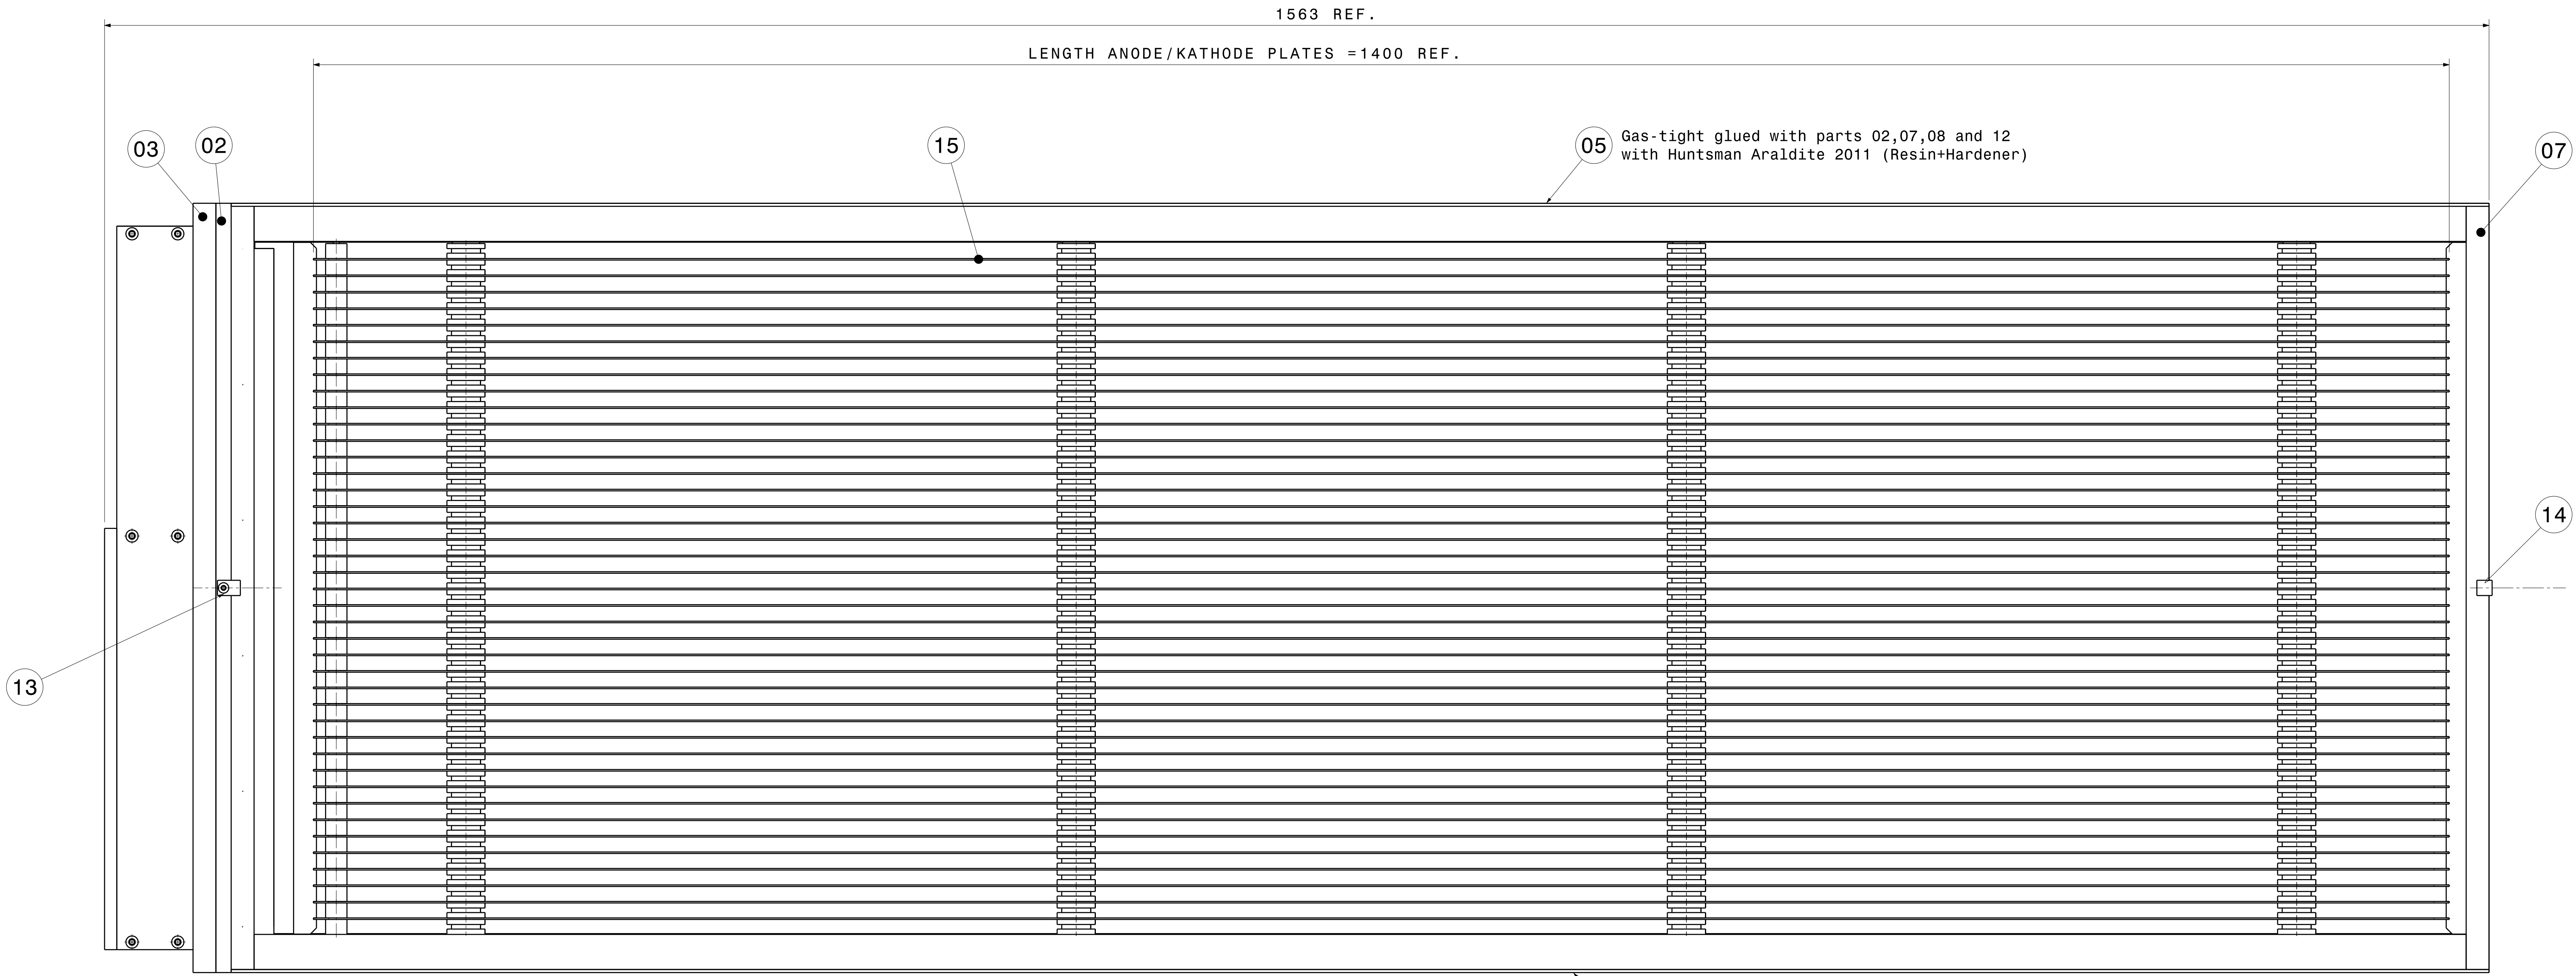

Front view  
Scale: 1:2  
(NOTE: POS.NR. 01 NOT DRAWN)

GENERAL REMARKS:

1. USE OF THIS DEVICE IS ONLY ALLOWED BY AUTHORISED PERSONNEL.
2. BEFORE USE READ INSTRUCTIONS MANUAL CAREFULLY !
3. ANY MODIFICATION ON THIS DEVICE, UNLESS OTHERWISE STATED IN THE INSTRUCTIONS MANUAL, IS STRICTLY FORBIDDEN !
4. IN CASE OF DOUBTS CONCERNING WORKING, SAFETY, ETC. PLEASE CONTACT THE SUPPLIER !

MASS: APPROX. 90 KG

AS BUILT

Project: R&D Spark Chamber			
Library: Large Spark Chamber			
Name: Assembly Large Spark Chamber Sheet 1/4			
Item number: AA0244			
Revision number: 40091-ME-00204			