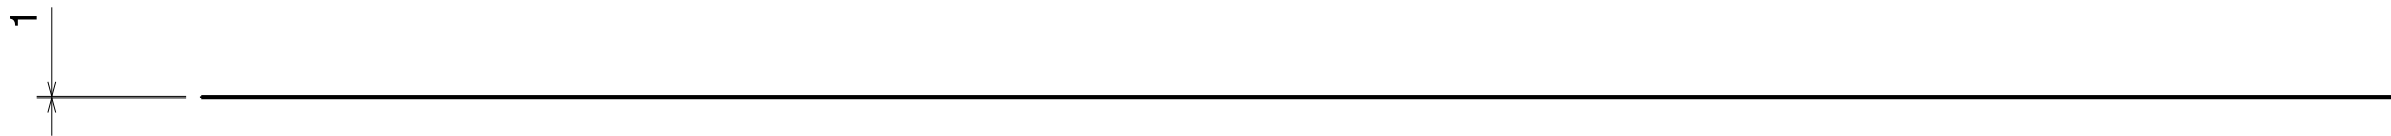


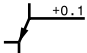
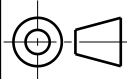

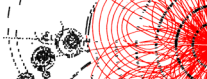


Front view
Scale: 1:5



Bottom view
Scale: 1:5

AS BUILT

General tolerances unless otherwise stated according to :ISO-2768-mK-E Geometrical tolerances unless otherwise stated according to:ISO-8015-E Roughness unless otherwise stated according to :ISO-1302		 +0.1	Material: PVC (zwart)	
Project: R&D Spark Chamber		Units: mm	Date: 10/02/2010	Revision: A
Library: Large Spark Chamber		Size: A3	Engineer: A. Korporaal	
Name: Insulator plate			Checked: A. Korporaal	
Item number: AA0252			Status: Released	
 National Institute for Subatomic Physics Science Park 105, 1098XG Amsterdam				Nikhef number: 40091 -ME- 00159
This drawing may not be used for commercial purposes without written authorisation.				