



Front view Scale: 1:1

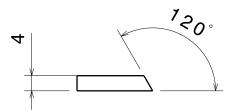

Bottom view Scale: 1:1

AS BUILT

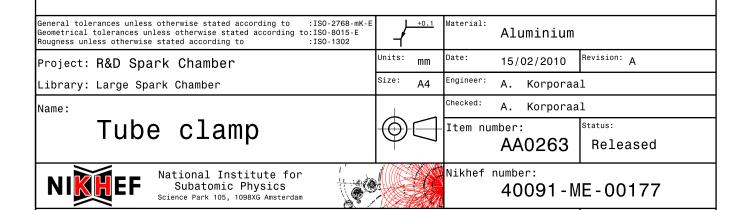

This drawing may not be used for commercial purposes without written authorisation.