




Back view  
Scale: 1:2



Front View  
Scale: 1:2

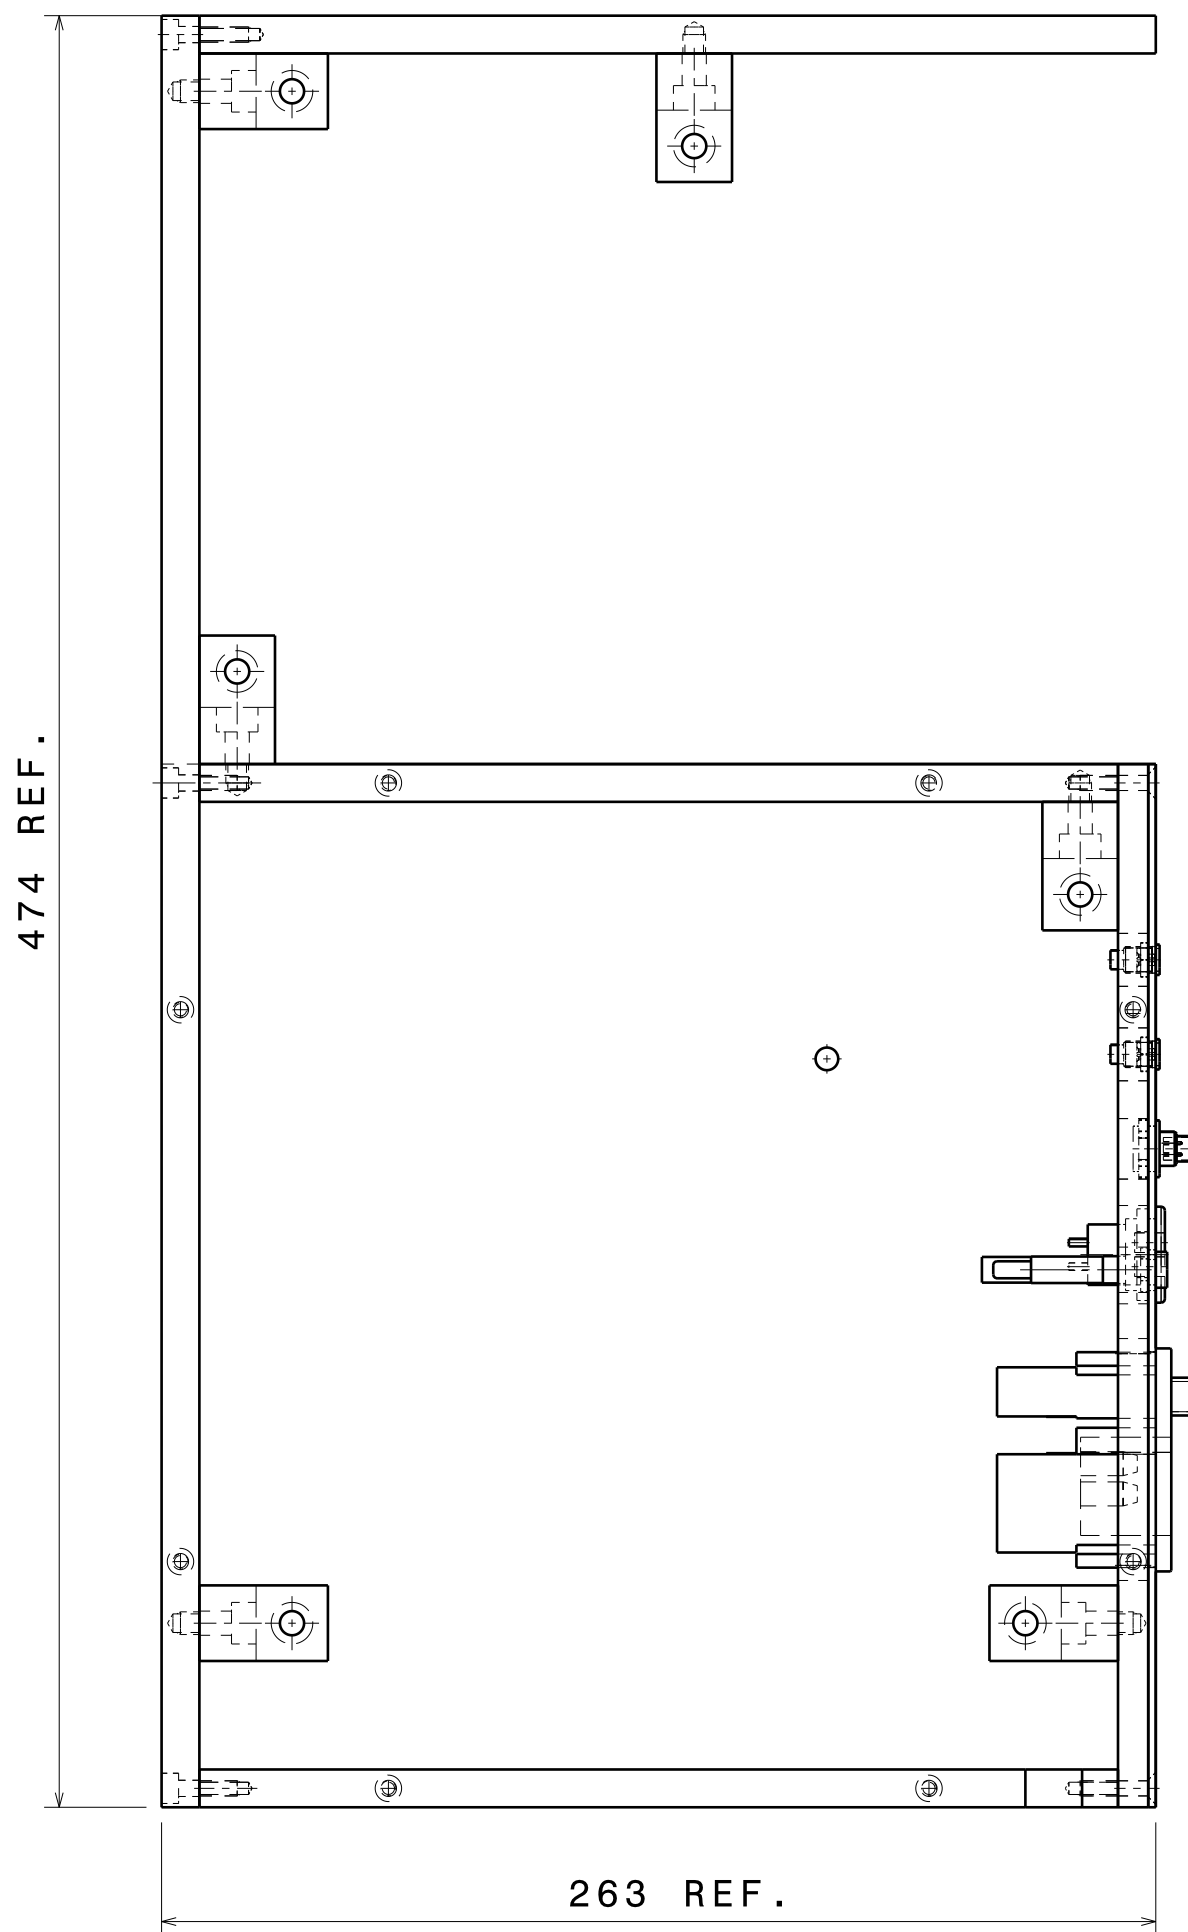


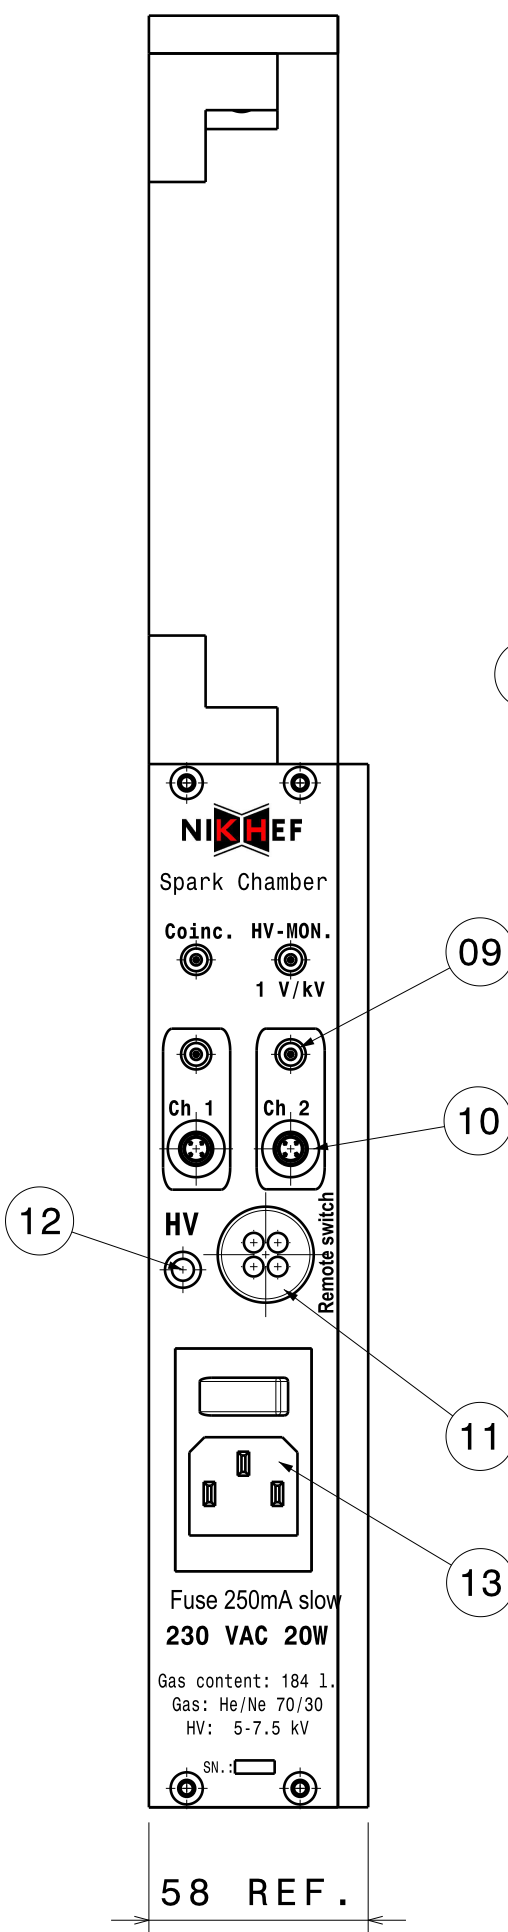

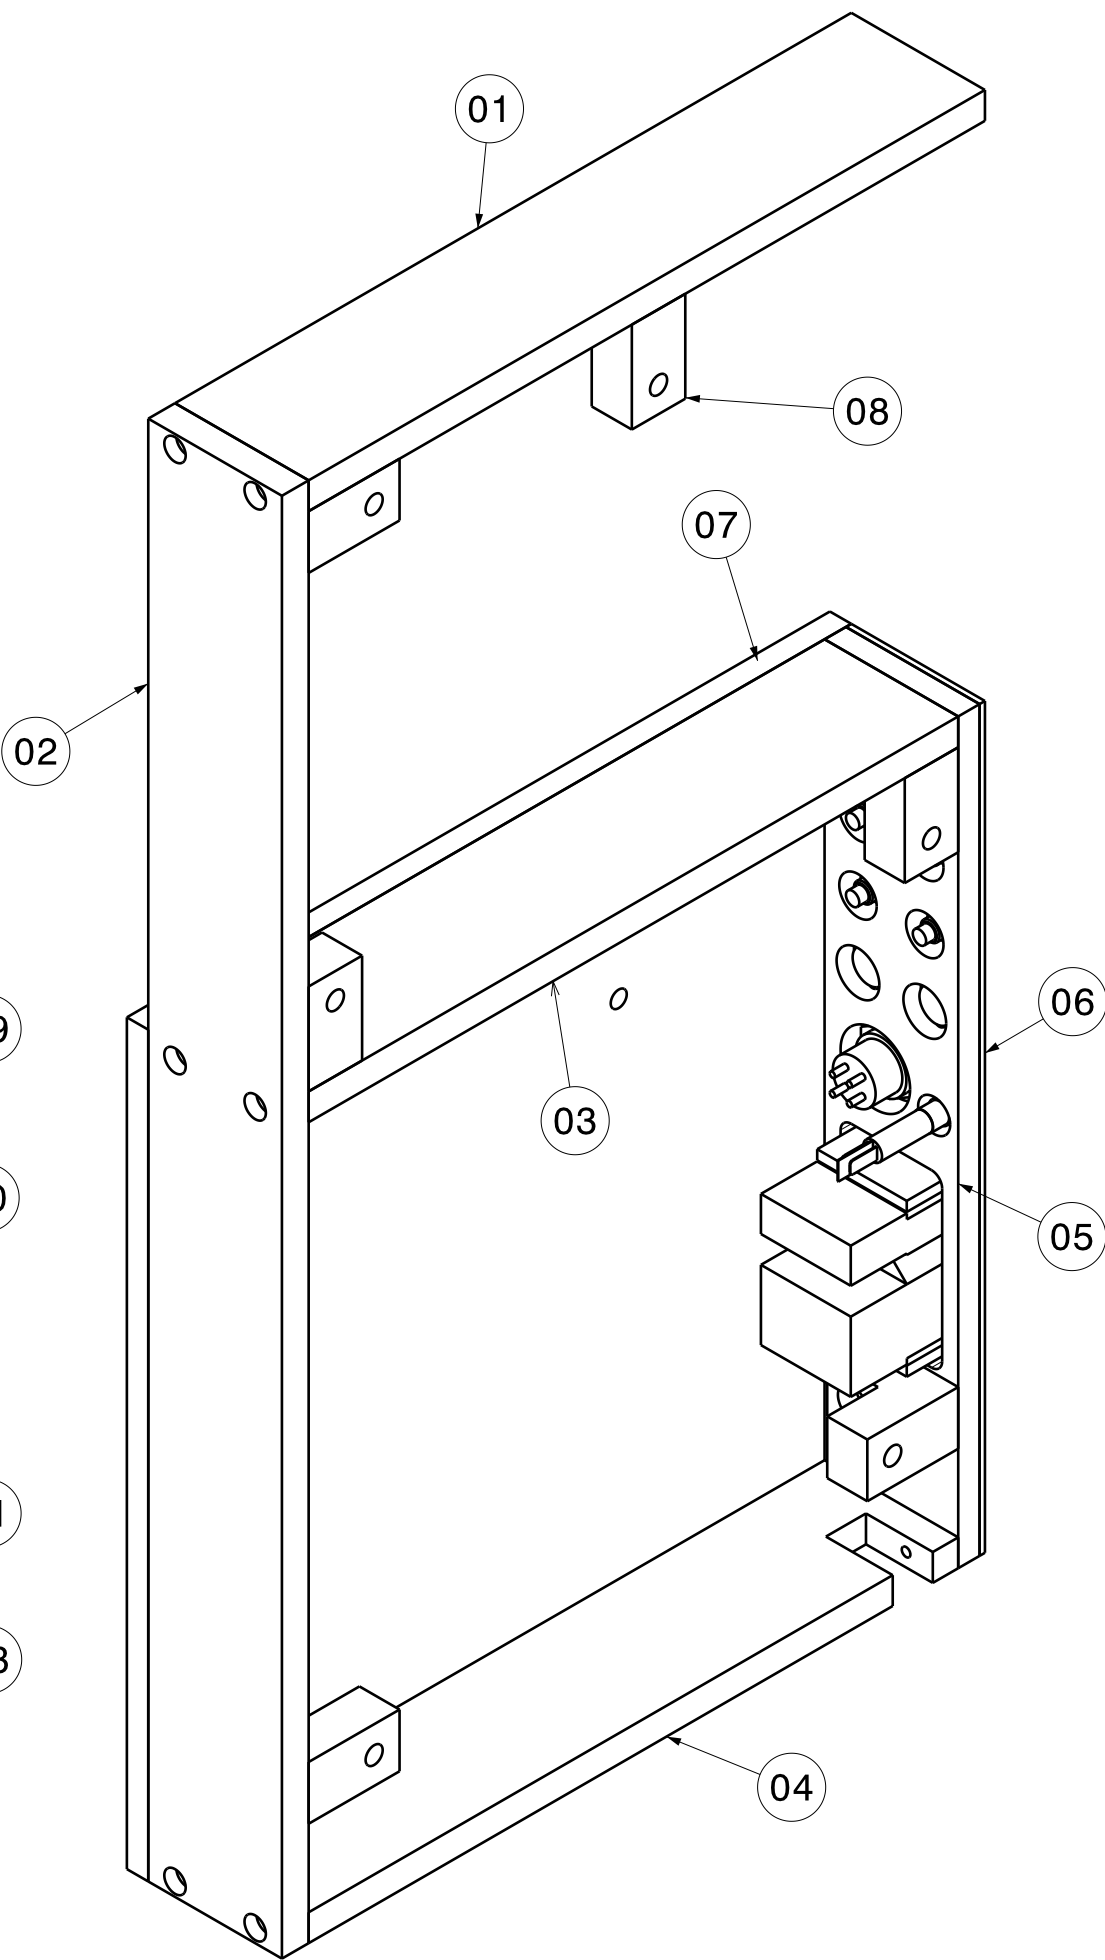Right view  
Scale: 1:2



Isometric view  
Scale: 1:2

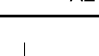AS BUILT

General tolerances unless otherwise stated according to :ISO-2768-mK-E Geometrical tolerances unless otherwise stated according to:ISO-8015-E Roughness unless otherwise stated according to :ISO-1302		Units: mm	Date: 15/02/2010	Revision: A
Project: R&D Spark Chamber		Size: A2	Engineer: A. Korpelaar	
Library: Large Spark Chamber			Checked: A. Korpelaar	
Name: Assembly Servicing Housing			Item number: AA0296	Status: Released
 National Institute for Subatomic Physics Science Park 105, 1098XG Amsterdam		 Nikhef number: 40091-ME-00191		
This drawing may not be used for commercial purposes without written authorisation.				