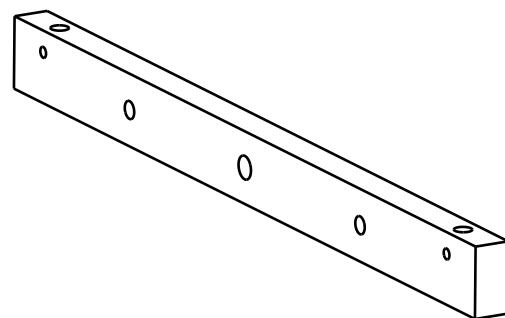
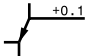
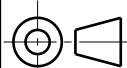

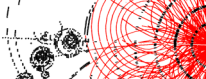


Section view A-A



AS BUILT

General tolerances unless otherwise stated according to :ISO-2768-mK-E Geometrical tolerances unless otherwise stated according to:ISO-8015-E Roughness unless otherwise stated according to :ISO-1302		 +0.1	Material: Copper	
Project: R&D Spark Chamber		Units: mm	Date: 15/02/2010	Revision: A
Library: Large Spark Chamber		Size: A3	Engineer: A. Korporaal	
Name: Resistor Ground Strip 1			Checked: A. Korporaal	
			Item number: AA0275	Status: Released
 National Institute for Subatomic Physics Science Park 105, 1098XG Amsterdam				Nikhef number: 40091 -ME- 00176
This drawing may not be used for commercial purposes without written authorisation.				