
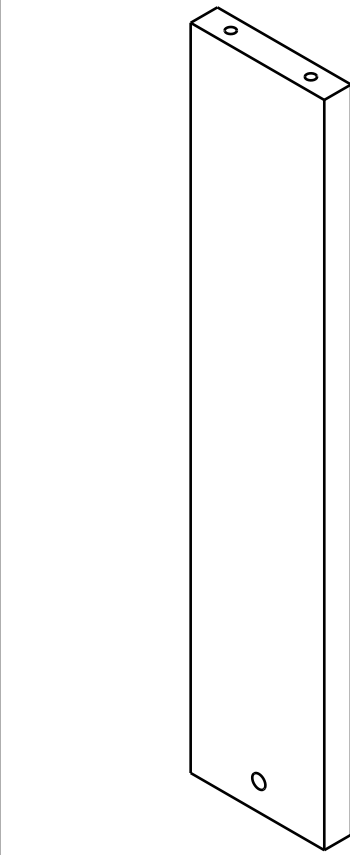


Rear view  
Scale: 1:2


Left view  
Scale: 1:2

Front view  
Scale: 1:2

Right view  
Scale: 1:2

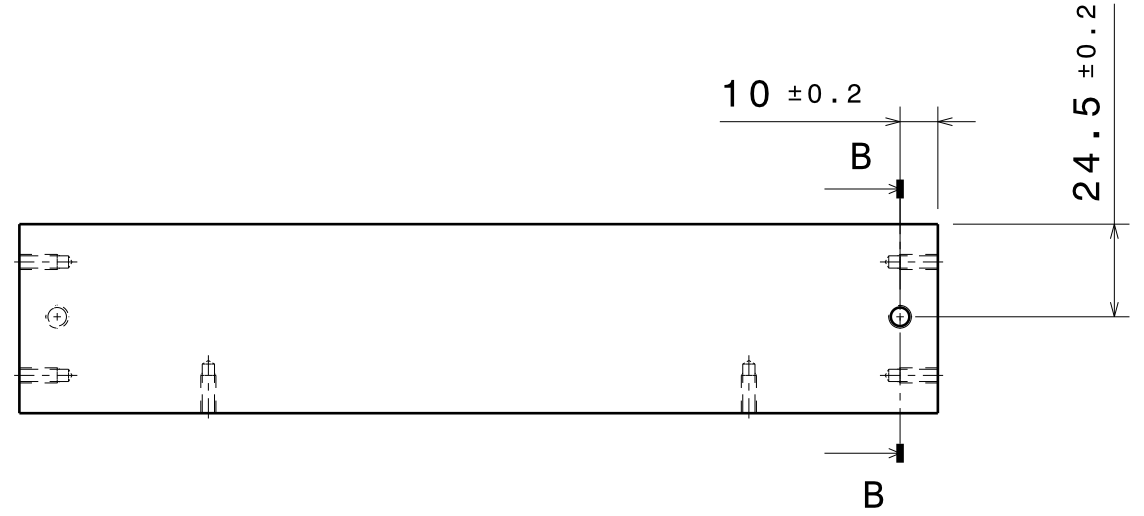


Isometric view  
Scale: 1:2

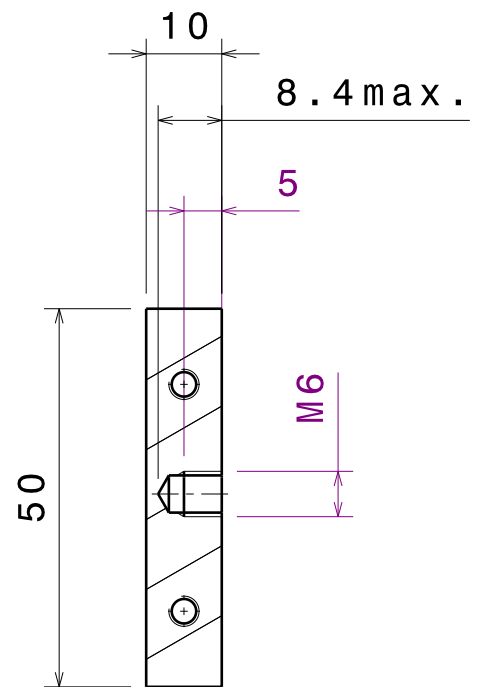




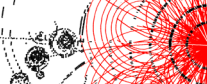
Section view A-A  
Scale: 1:1

Bottom view  
Scale: 1:2

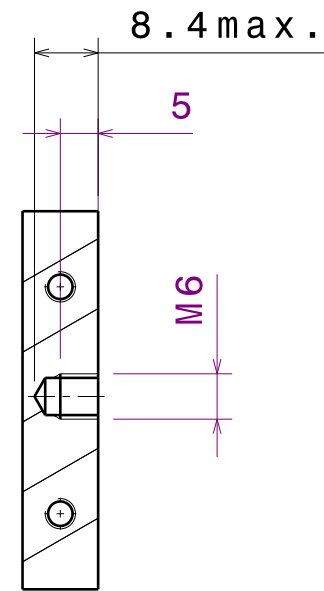

Section view B-B  
Scale: 1:1

**AS BUILT**

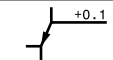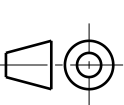General tolerances unless otherwise stated according to :ISO-2768-mK-E Geometrical tolerances unless otherwise stated according to:ISO-8015-E Roughness unless otherwise stated according to :ISO-1302				Material: PVC (Black)	
Project: R&D Spark Chamber Library: Large Spark Chamber		Units: mm	Date: 15/02/2010		Revision: A
		Size: A3	Engineer: A. Korporaal		
Name: Service Housing Plate 3			Checked: A. Korporaal		
			Item number: AA0300	Status: Released	
 National Institute for Subatomic Physics Science Park 105, 1098XG Amsterdam				Nikhef number: 40091 -ME- 00184	
This drawing may not be used for commercial purposes without written authorisation.					