




Top view
Scale: 1:1

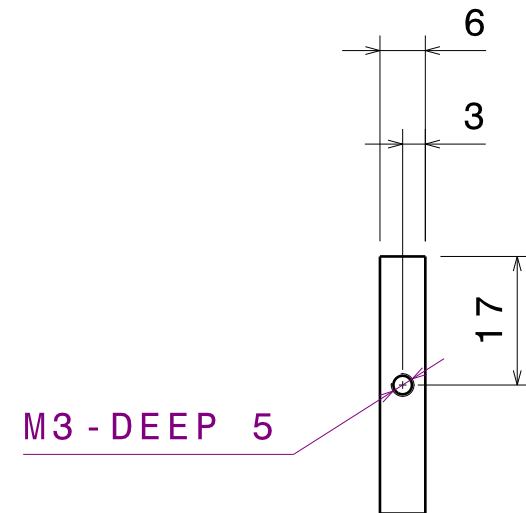


Left view
Scale: 1:1

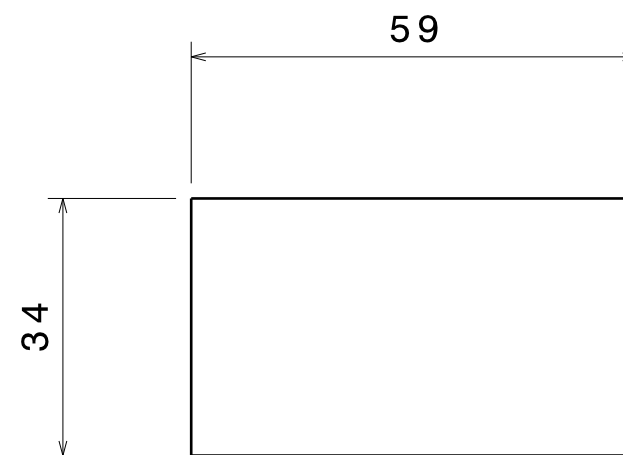

Front view
Scale: 1:1


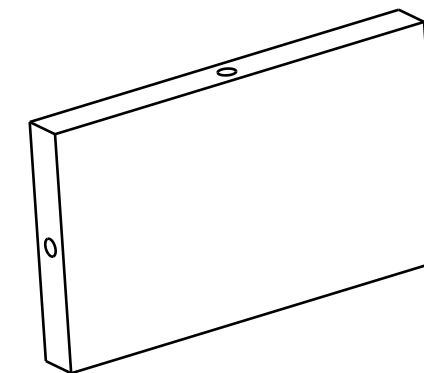

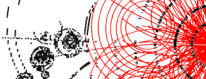


Isometric view
Scale: 1:1

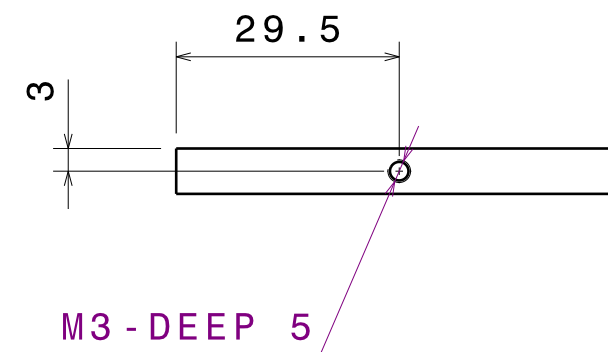

Bottom view
Scale: 1:1

AS BUILT

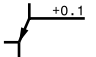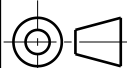General tolerances unless otherwise stated according to :ISO-2768-mK-E Geometrical tolerances unless otherwise stated according to:ISO-8015-E Roughness unless otherwise stated according to :ISO-1302			Material: PVC	
Project: R&D Spark Chamber		Units: mm	Date: 15/02/2010	Revision: A
Library: Large Spark Chamber		Size: A3	Engineer: A. Korporaal	
Name: Gas Control Side Wall			Checked: A. Korporaal	
			Item number: AA0314	Status: Released
 National Institute for Subatomic Physics Science Park 105, 1098XG Amsterdam		 Nikhef number: 40091 -ME -00195		
This drawing may not be used for commercial purposes without written authorisation.				