
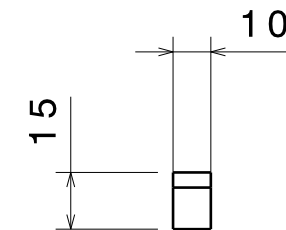



Front view  
Scale: 1:2

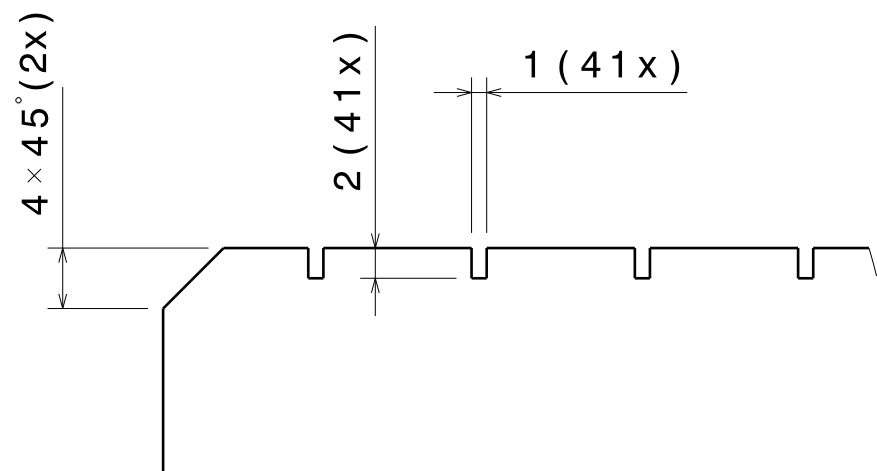

Right view  
Scale: 1:2




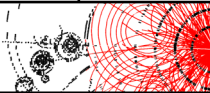


Detail A  
Scale: 2:1

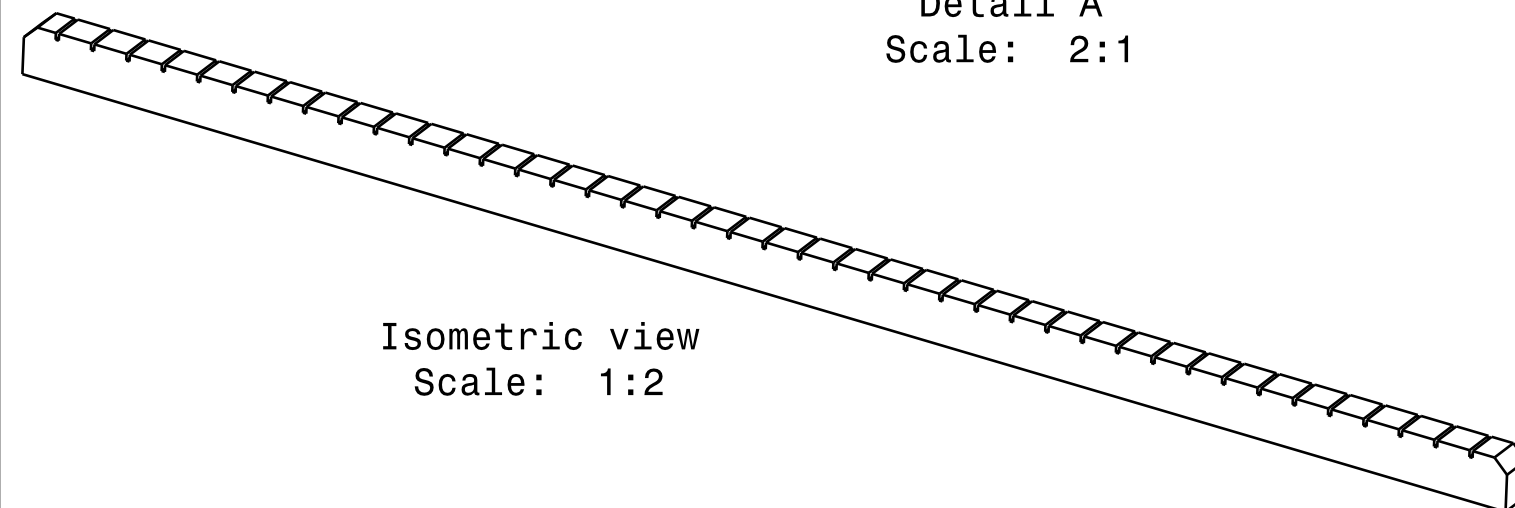

Isometric view  
Scale: 1:2

**AS BUILT**

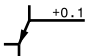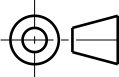General tolerances unless otherwise stated according to :ISO-2768-mK-E Geometrical tolerances unless otherwise stated according to:ISO-8015-E Roughness unless otherwise stated according to :ISO-1302				Material: PVC (zwart)	
Project: R&D Spark Chamber		Units: mm	Date: 11/02/2010	Revision: A	
Library: Large Spark Chamber		Size: A3	Engineer: A. Korporaal		
Name:  Electrode Spacer				Checked: A. Korporaal	
		Item number: AA0295		Status: Released	
 National Institute for Subatomic Physics Science Park 105, 1098XG Amsterdam				Nikhef number: 40091-ME-00171	
This drawing may not be used for commercial purposes without written authorisation.					