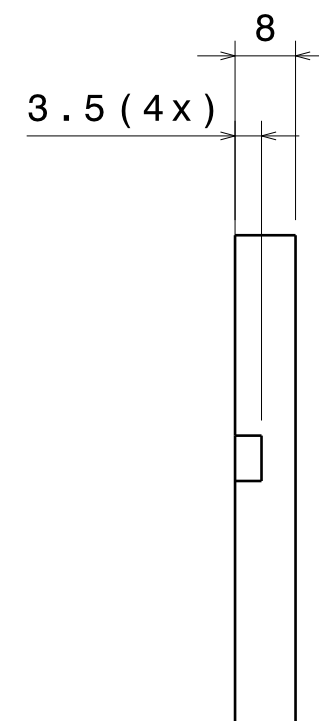
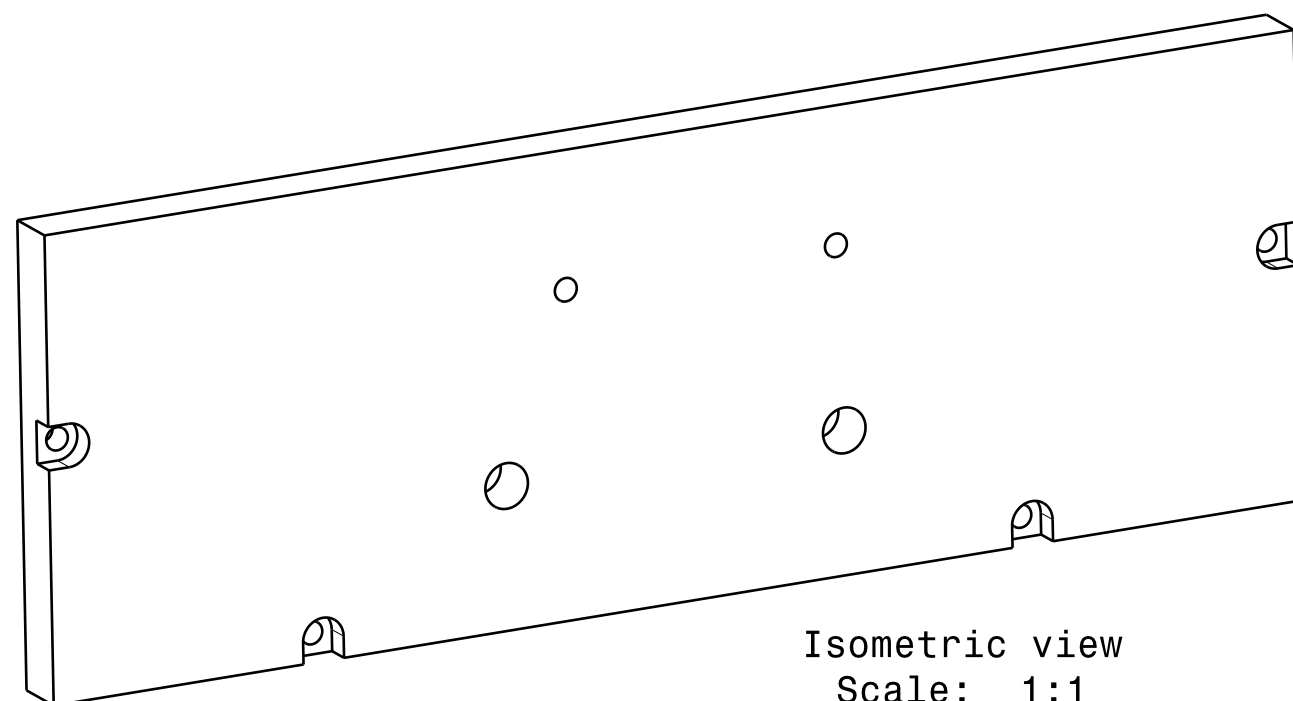


Front view
Scale: 1:1

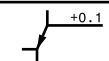
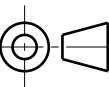

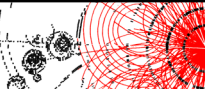


Right view
Scale: 1:1



Isometric view
Scale: 1:1

AS BUILT

General tolerances unless otherwise stated according to :ISO-2768-mK-E Geometrical tolerances unless otherwise stated according to:ISO-8015-E Roughness unless otherwise stated according to :ISO-1302				Material: Polycarbonate (Lexan)	
Project: R&D Spark Chamber		Units: mm	Date: 15/02/2010	Revision: A	
Library: Large Spark Chamber		Size: A3	Engineer: A. Korporaal		
Name: Gas Controle Cover 1				Checked: A. Korporaal	
		Item number: AA0315		Status: Released	
 National Institute for Subatomic Physics Science Park 105, 1098XG Amsterdam				Nikhef number: 40091 -ME- 00196	
This drawing may not be used for commercial purposes without written authorisation.					