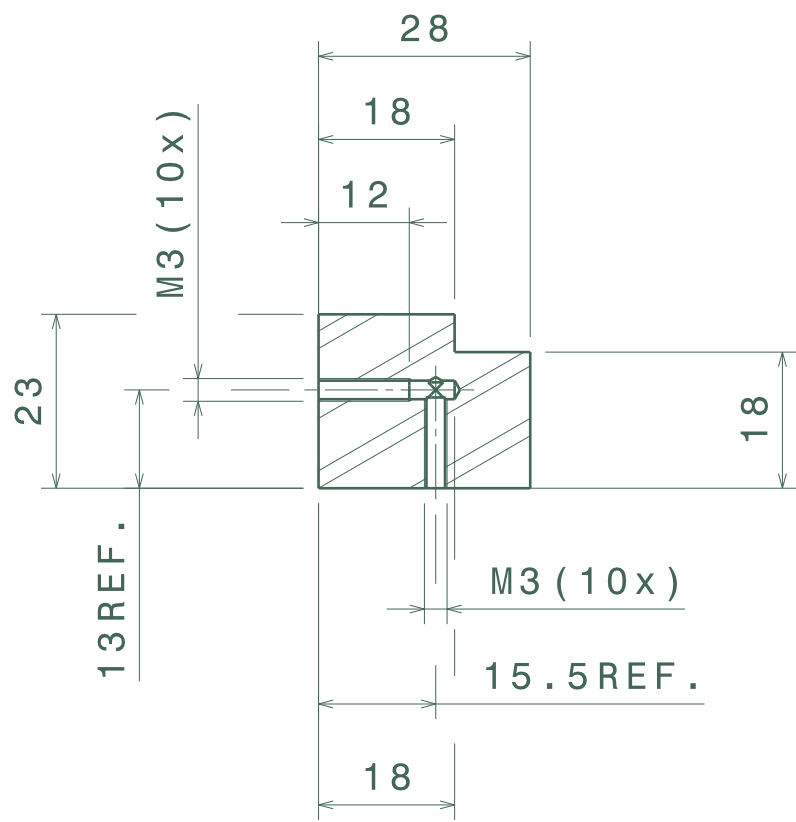




Top view
Scale: 2:5



Front view
Scale: 2:5

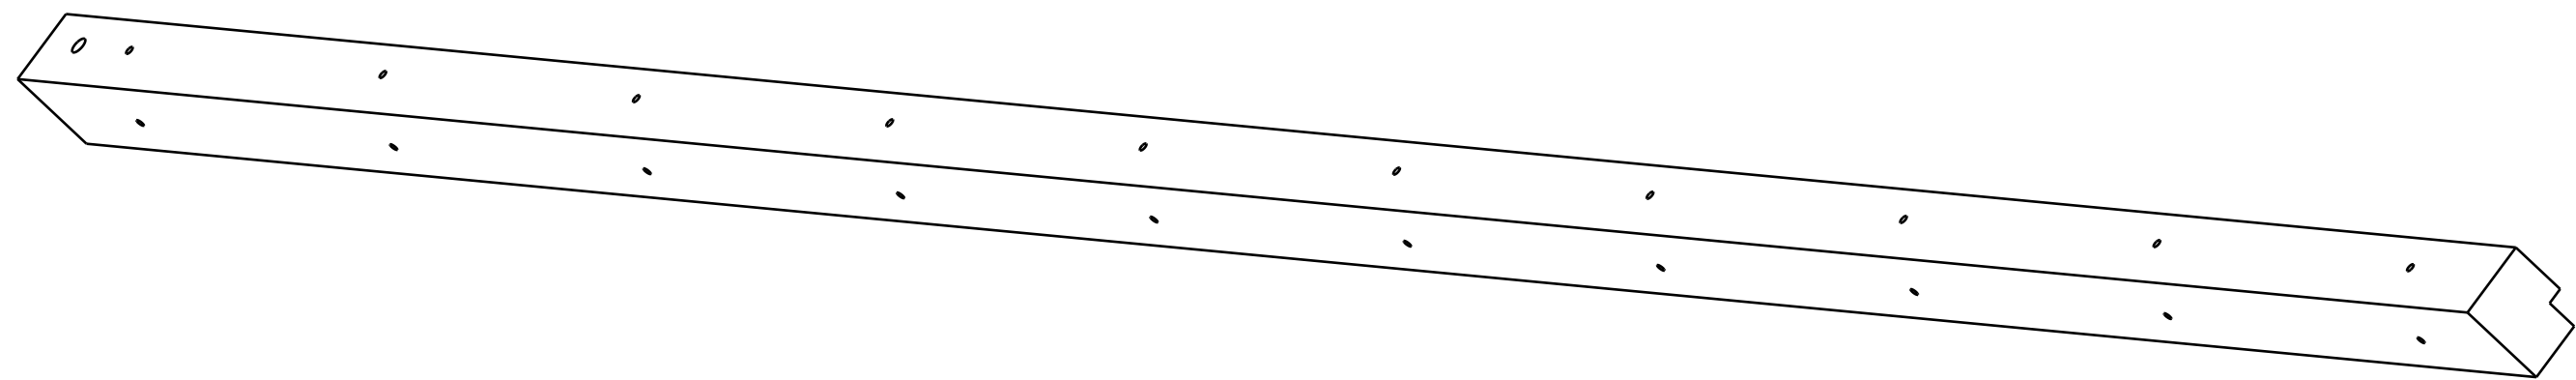


Section view A-A
Scale: 1:1





 
 
Bottom view
Scale: 2:5

Notes: 1. Part full black anodised after machining
2. Clean threaded hole (M6) with tap tool M6 after anodizing !!



Isometric view
Scale: 1:2

AS BUILT

General tolerances unless otherwise stated according to :ISO-2768-MC-E Geometrical tolerances unless otherwise stated according to:ISO-8015-E Surface unless otherwise stated according to :ISO-13002			Material: Aluminium	
Project: R&D Spark Chamber		Units: mm	Date: 22/09/2010	Revision: A
Library: Large Spark Chamber		Size: A1	Engineer: A. Korporaal	
Name:		Checked: A. Korporaal		
Back Strip Large			Item number: AA0254	Status: Released
 National Institute for Subatomic Physics Science Park 105, 1098IS Amsterdam		 Nikhef number: 40091-ME-00175		
This drawing may not be used for commercial purposes without written authorisation.				