



Front view
Scale: 1:3

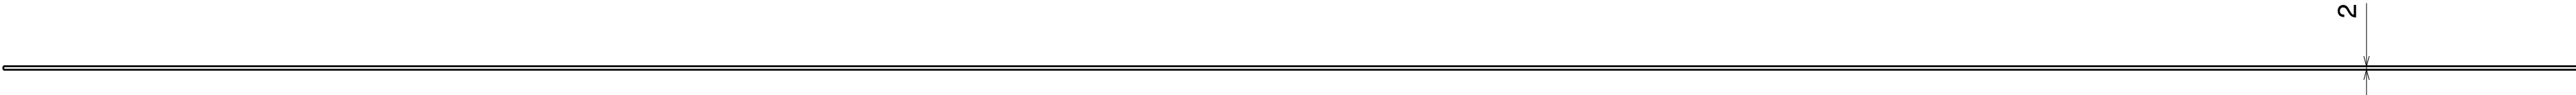

Bottom view
Scale: 1:3

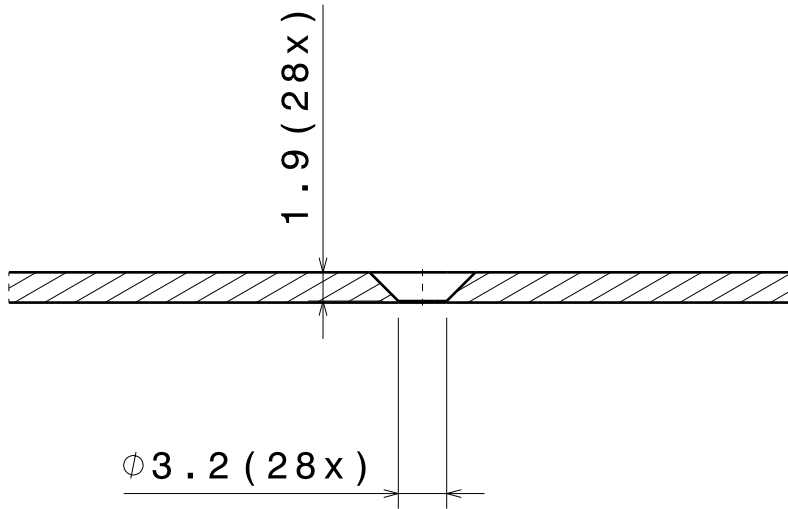

Section view A-A
Scale: 2:1

AS BUILT

General tolerances unless otherwise stated according to :ISO-2768-mK-E			Material: Aluminium	
Geometrical tolerances unless otherwise stated according to :ISO-8015-E			Units: mm	
Roughness unless otherwise stated according to :ISO-1302			Date: 10/02/2010	
Project: R&D Spark Chamber		Size: A2	Revision: A	
Library: Large Spark Chamber			Engineer: A. Korpelaar	
Name: Top and Bottom Plate			Checked: A. Korpelaar	
			Item number: AA0249	
			Status: Released	
		National Institute for Subatomic Physics		Nikhef number: 40091-ME-00148
Science Park 105, 1098XG Amsterdam				
This drawing may not be used for commercial purposes without written authorisation.				