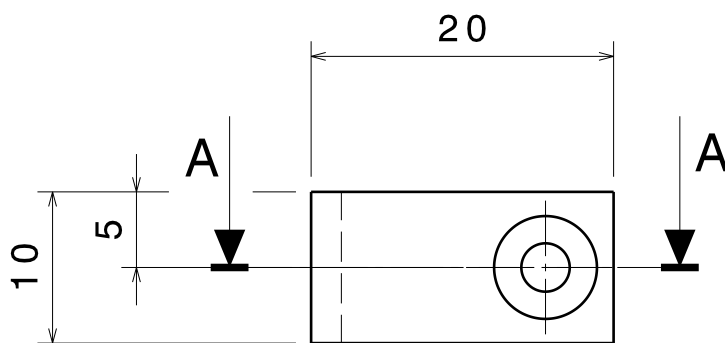
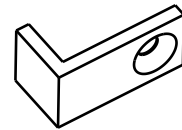


Section view A-A
Scale: 2:1

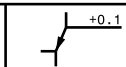
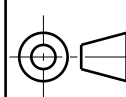

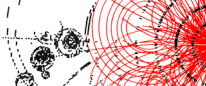


Front view
Scale: 2:1



Isometric view
Scale: 1:1

AS BUILT

General tolerances unless otherwise stated according to :ISO-2768-mK-E Geometrical tolerances unless otherwise stated according to:ISO-8015-E Roughness unless otherwise stated according to :ISO-1302				Material: Aluminium	
Project: R&D Spark Chamber		Units: mm	Date: 10/02/2010	Revision: A	
Library: Large Spark Chamber		Size: A4	Engineer: A. Korporaal		
Name: Safety Clip 2			Checked: A. Korporaal		
			Item number: AA0260	Status: Released	
 National Institute for Subatomic Physics Science Park 105, 1098XG Amsterdam				Nikhef number: 40091 - ME - 00150	
This drawing may not be used for commercial purposes without written authorisation.					