




Section view B-B
Scale: 1:1

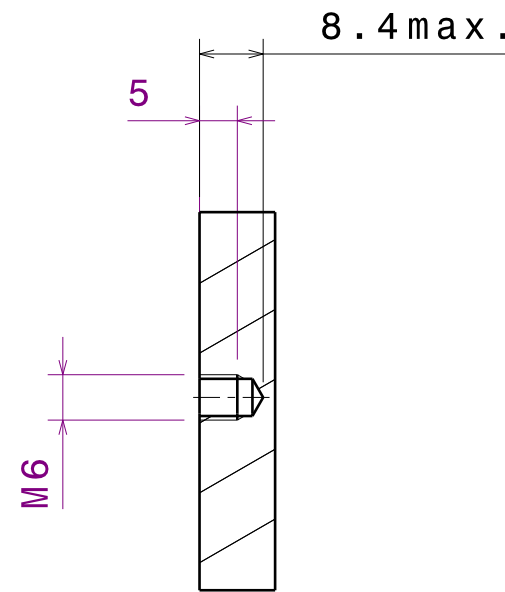


Section view A-A
Scale: 1:1

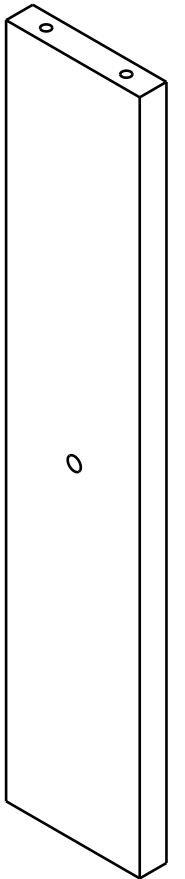

Isometric view
Scale: 1:2


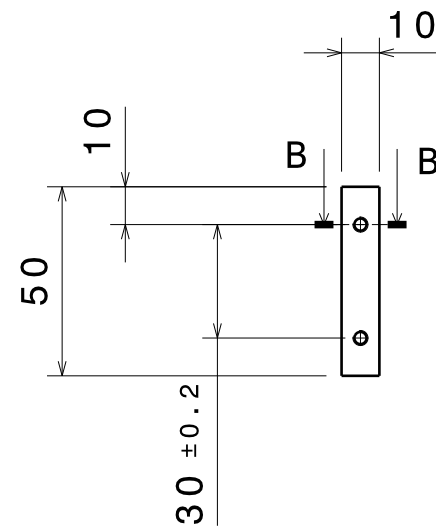

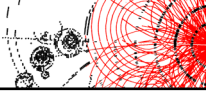


Front view
Scale: 1:2

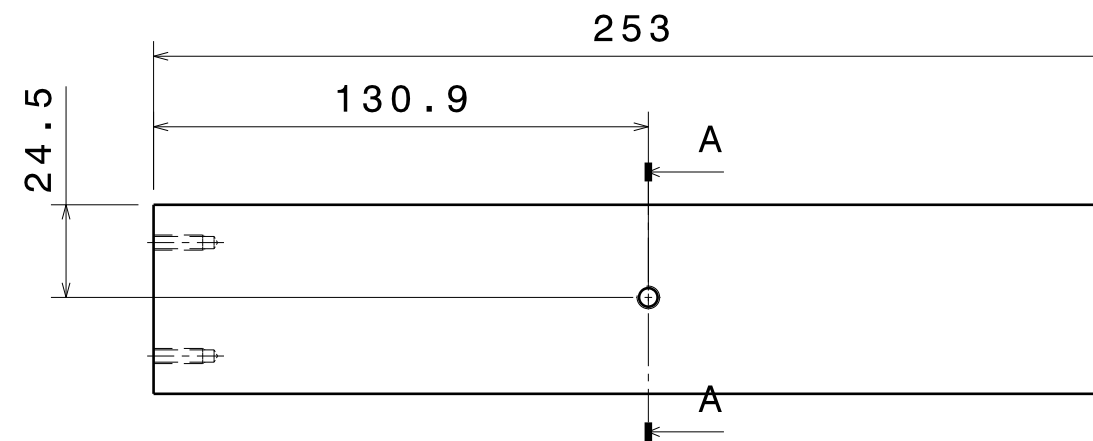

Right view
Scale: 1:2

AS BUILT

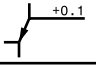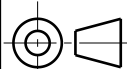General tolerances unless otherwise stated according to :ISO-2768-mK-E Geometrical tolerances unless otherwise stated according to:ISO-8015-E Roughness unless otherwise stated according to :ISO-1302		 +0.1	Material: PVC (Black)	
Project: R&D Spark Chamber		Units: mm	Date: 15/02/2010	Revision: A
Library: Large Spark Chamber		Size: A3	Engineer: A. Korporaal	
Name: Service Housing Plate 1			Checked: A. Korporaal	
			Item number: AA0297	Status: Released
 National Institute for Subatomic Physics Science Park 105, 1098XG Amsterdam				Nikhef number: 40091-ME-00182
This drawing may not be used for commercial purposes without written authorisation.				