

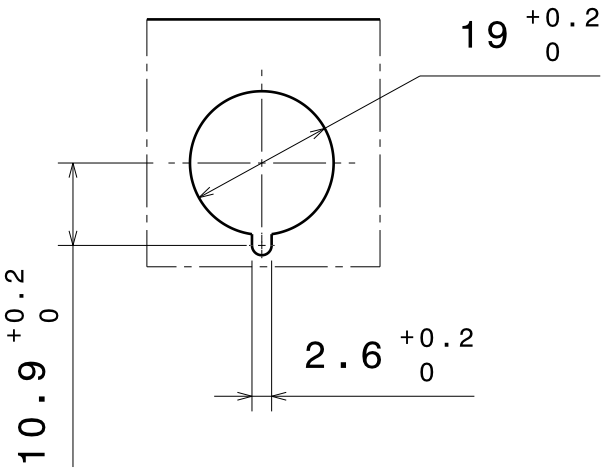
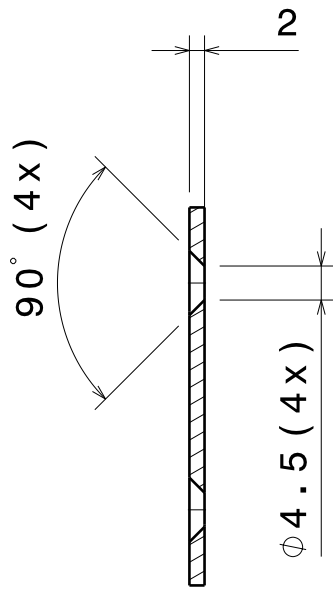
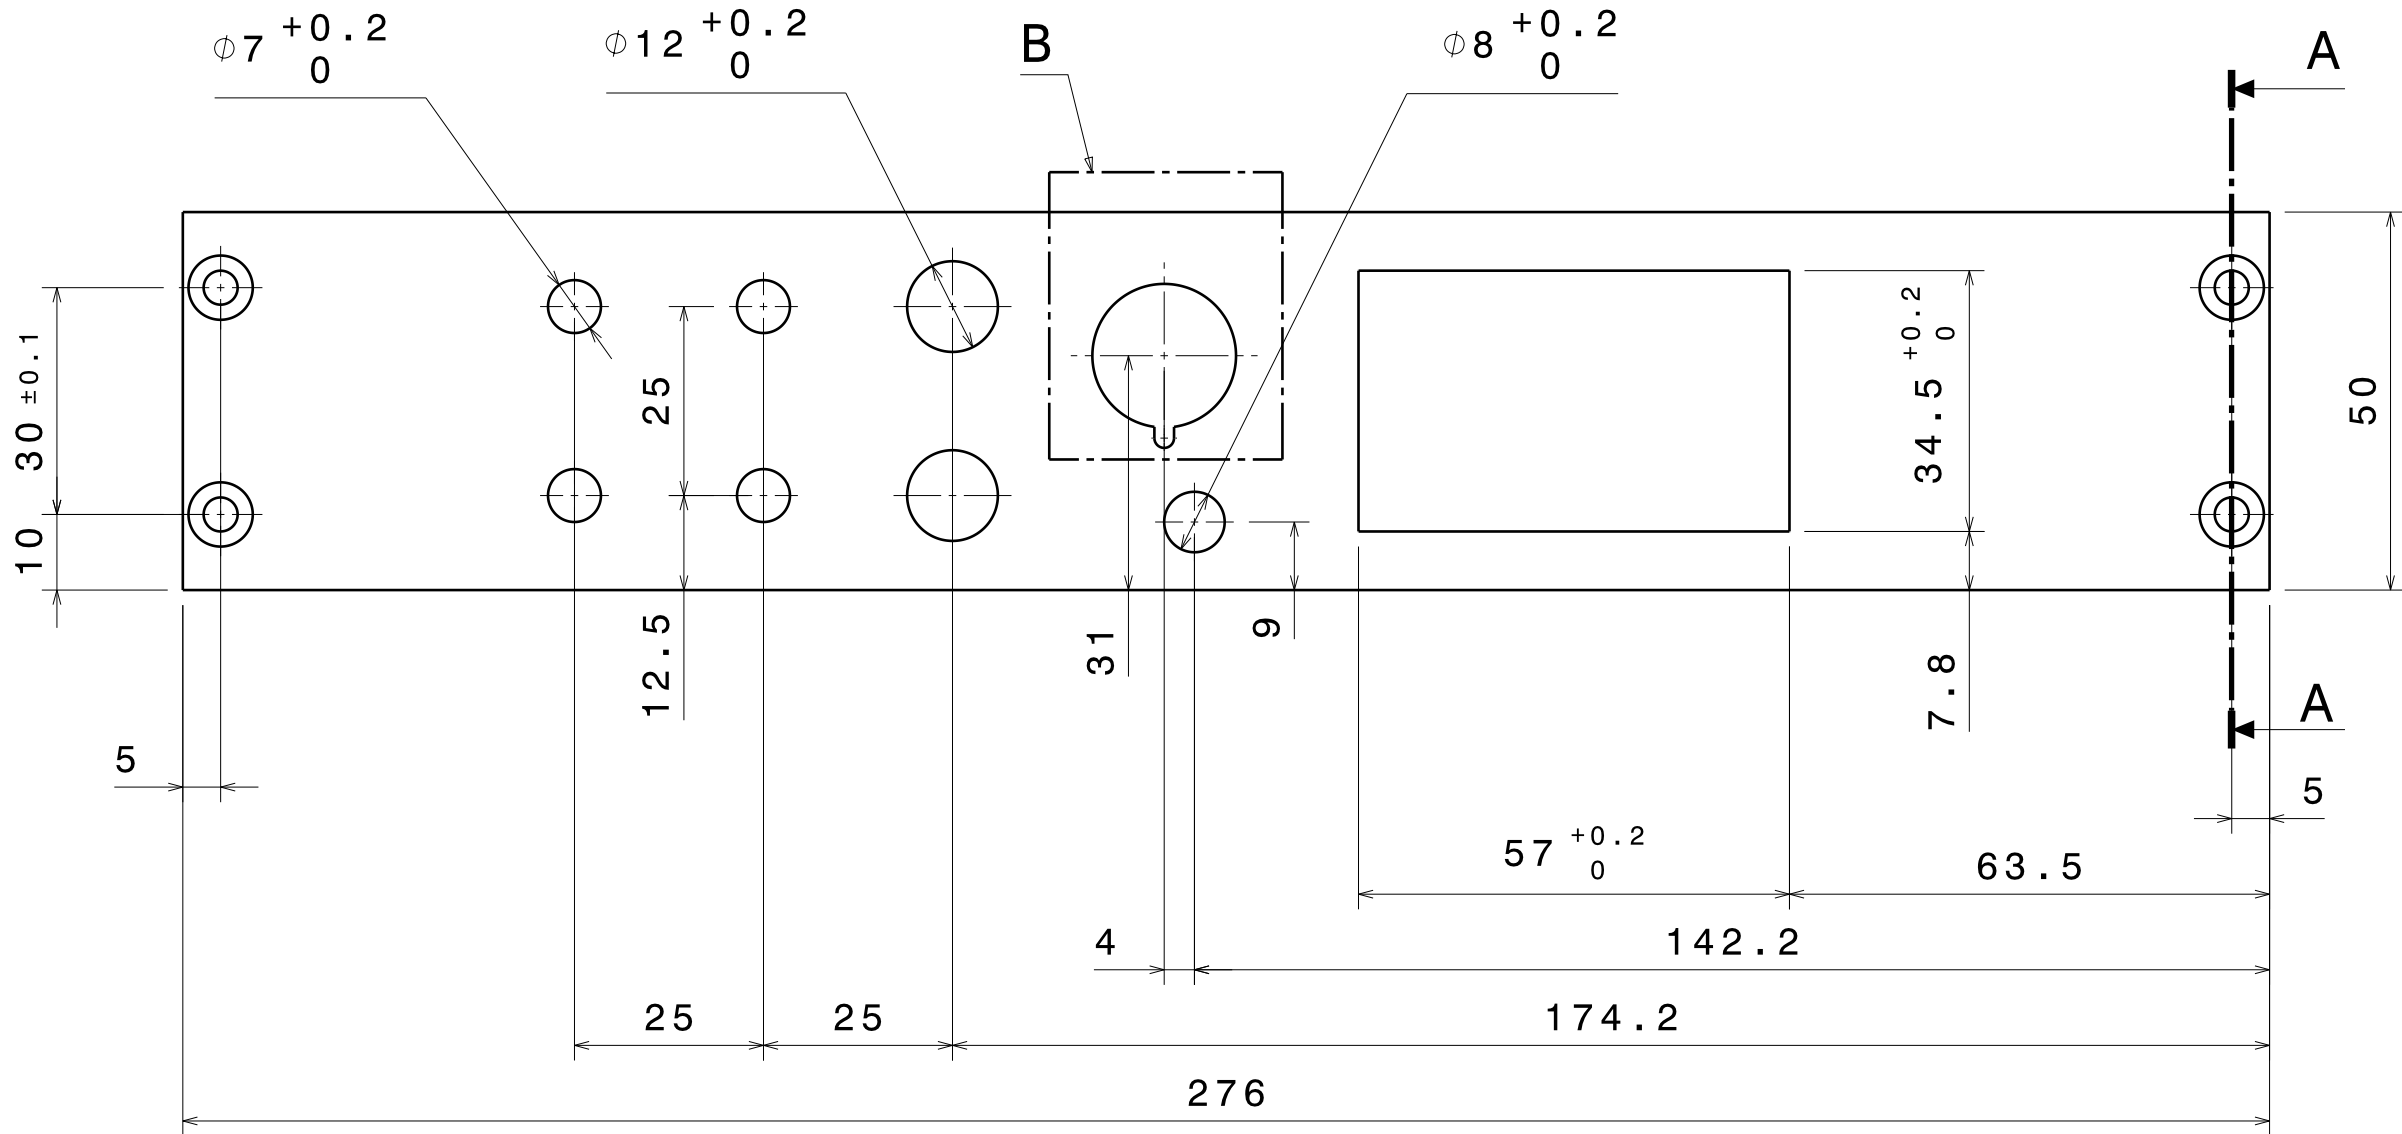
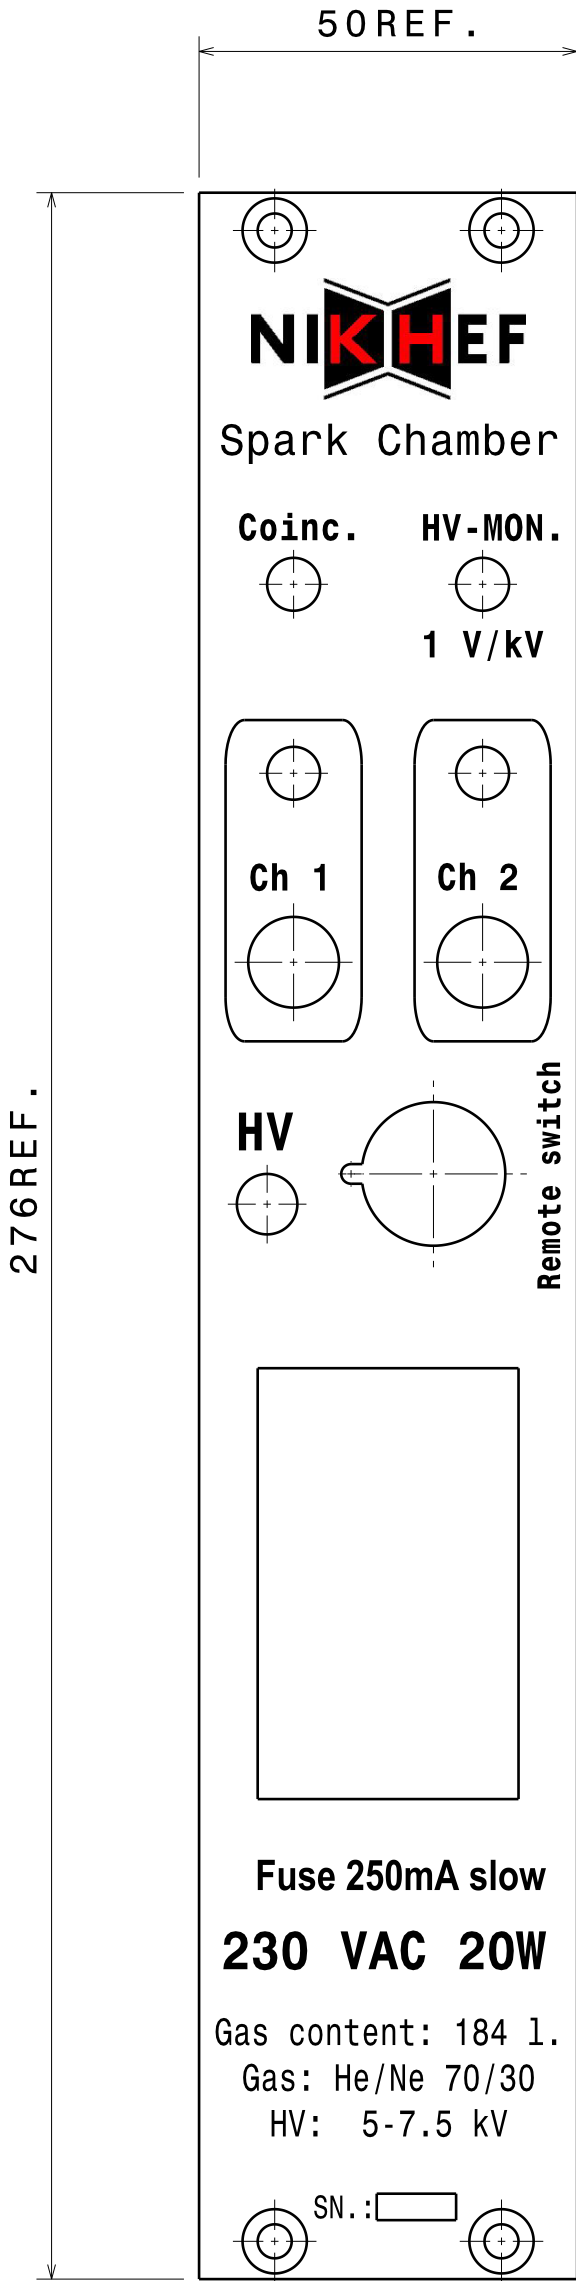


Kleur(en): NIKHEF ROOD
ALU TEKST
Tekstfont: SWISS 721LtBt

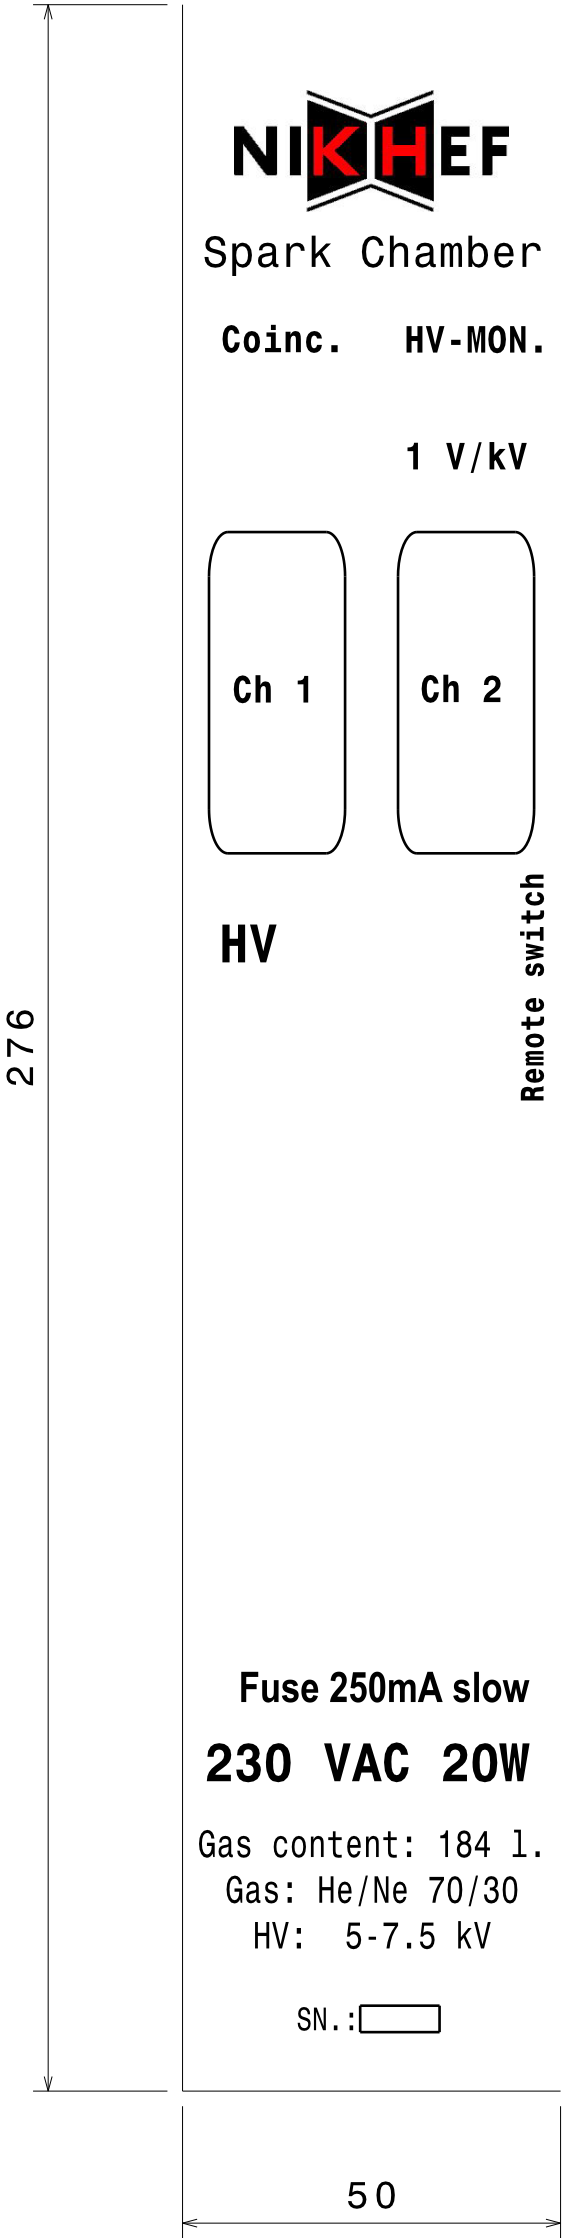

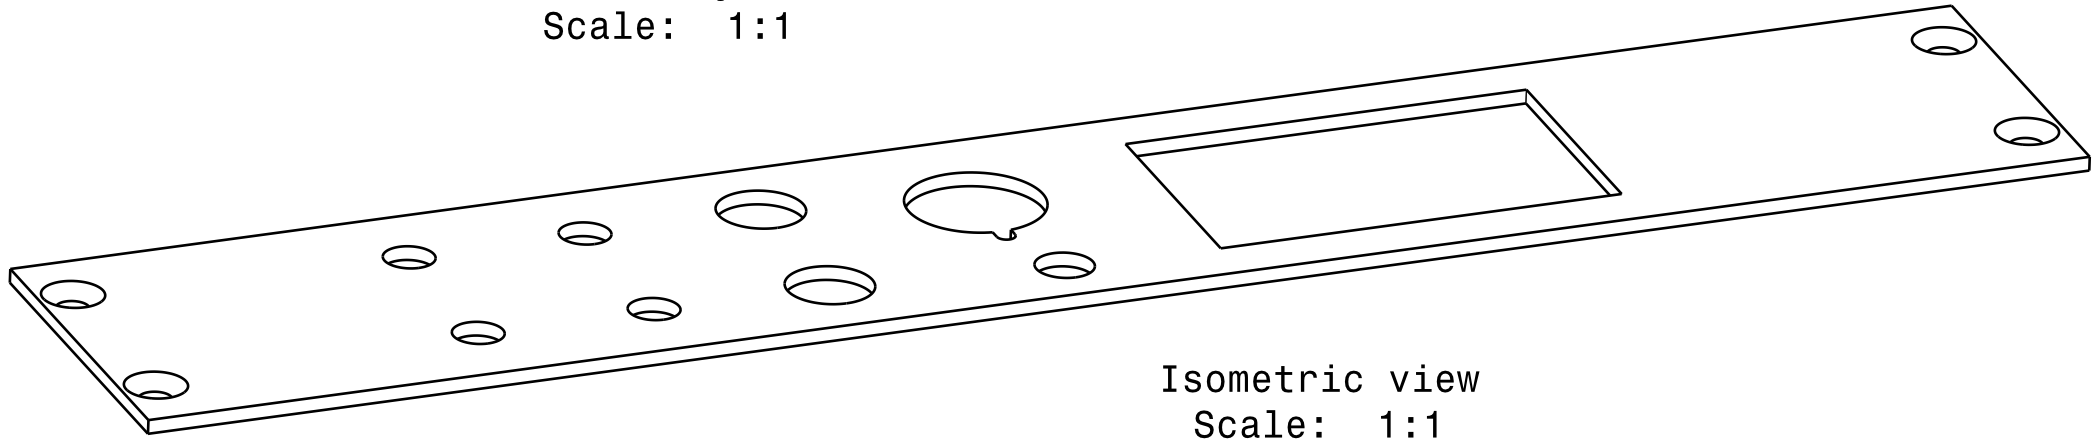



Detail B
Scale: 1:1

Section view A-A
Scale: 1:1



Isometric view
Scale: 1:1

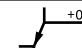AS BUILT

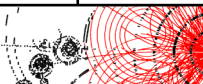General tolerances unless otherwise stated according to :ISO-2768-mK-E				Material: Aluminium	
Geometrical tolerances unless otherwise stated according to:ISO-8015-E		Units: mm		Date: 15/02/2010	Revision: A
Roughness unless otherwise stated according to :ISO-1302		Size: A2		Engineer: A. Korporaal	
Project: R&D Spark Chamber				Checked: A. Korporaal	
Library: Large Spark Chamber				Item number: AA0303	
Name: Patch panel				Status: Released	
		National Institute for Subatomic Physics Science Park 105, 1098XG Amsterdam		Nikhef number: 40091-ME-00188	
					
This drawing may not be used for commercial purposes without written authorisation.					