




Section view A-A
Scale: 1:2

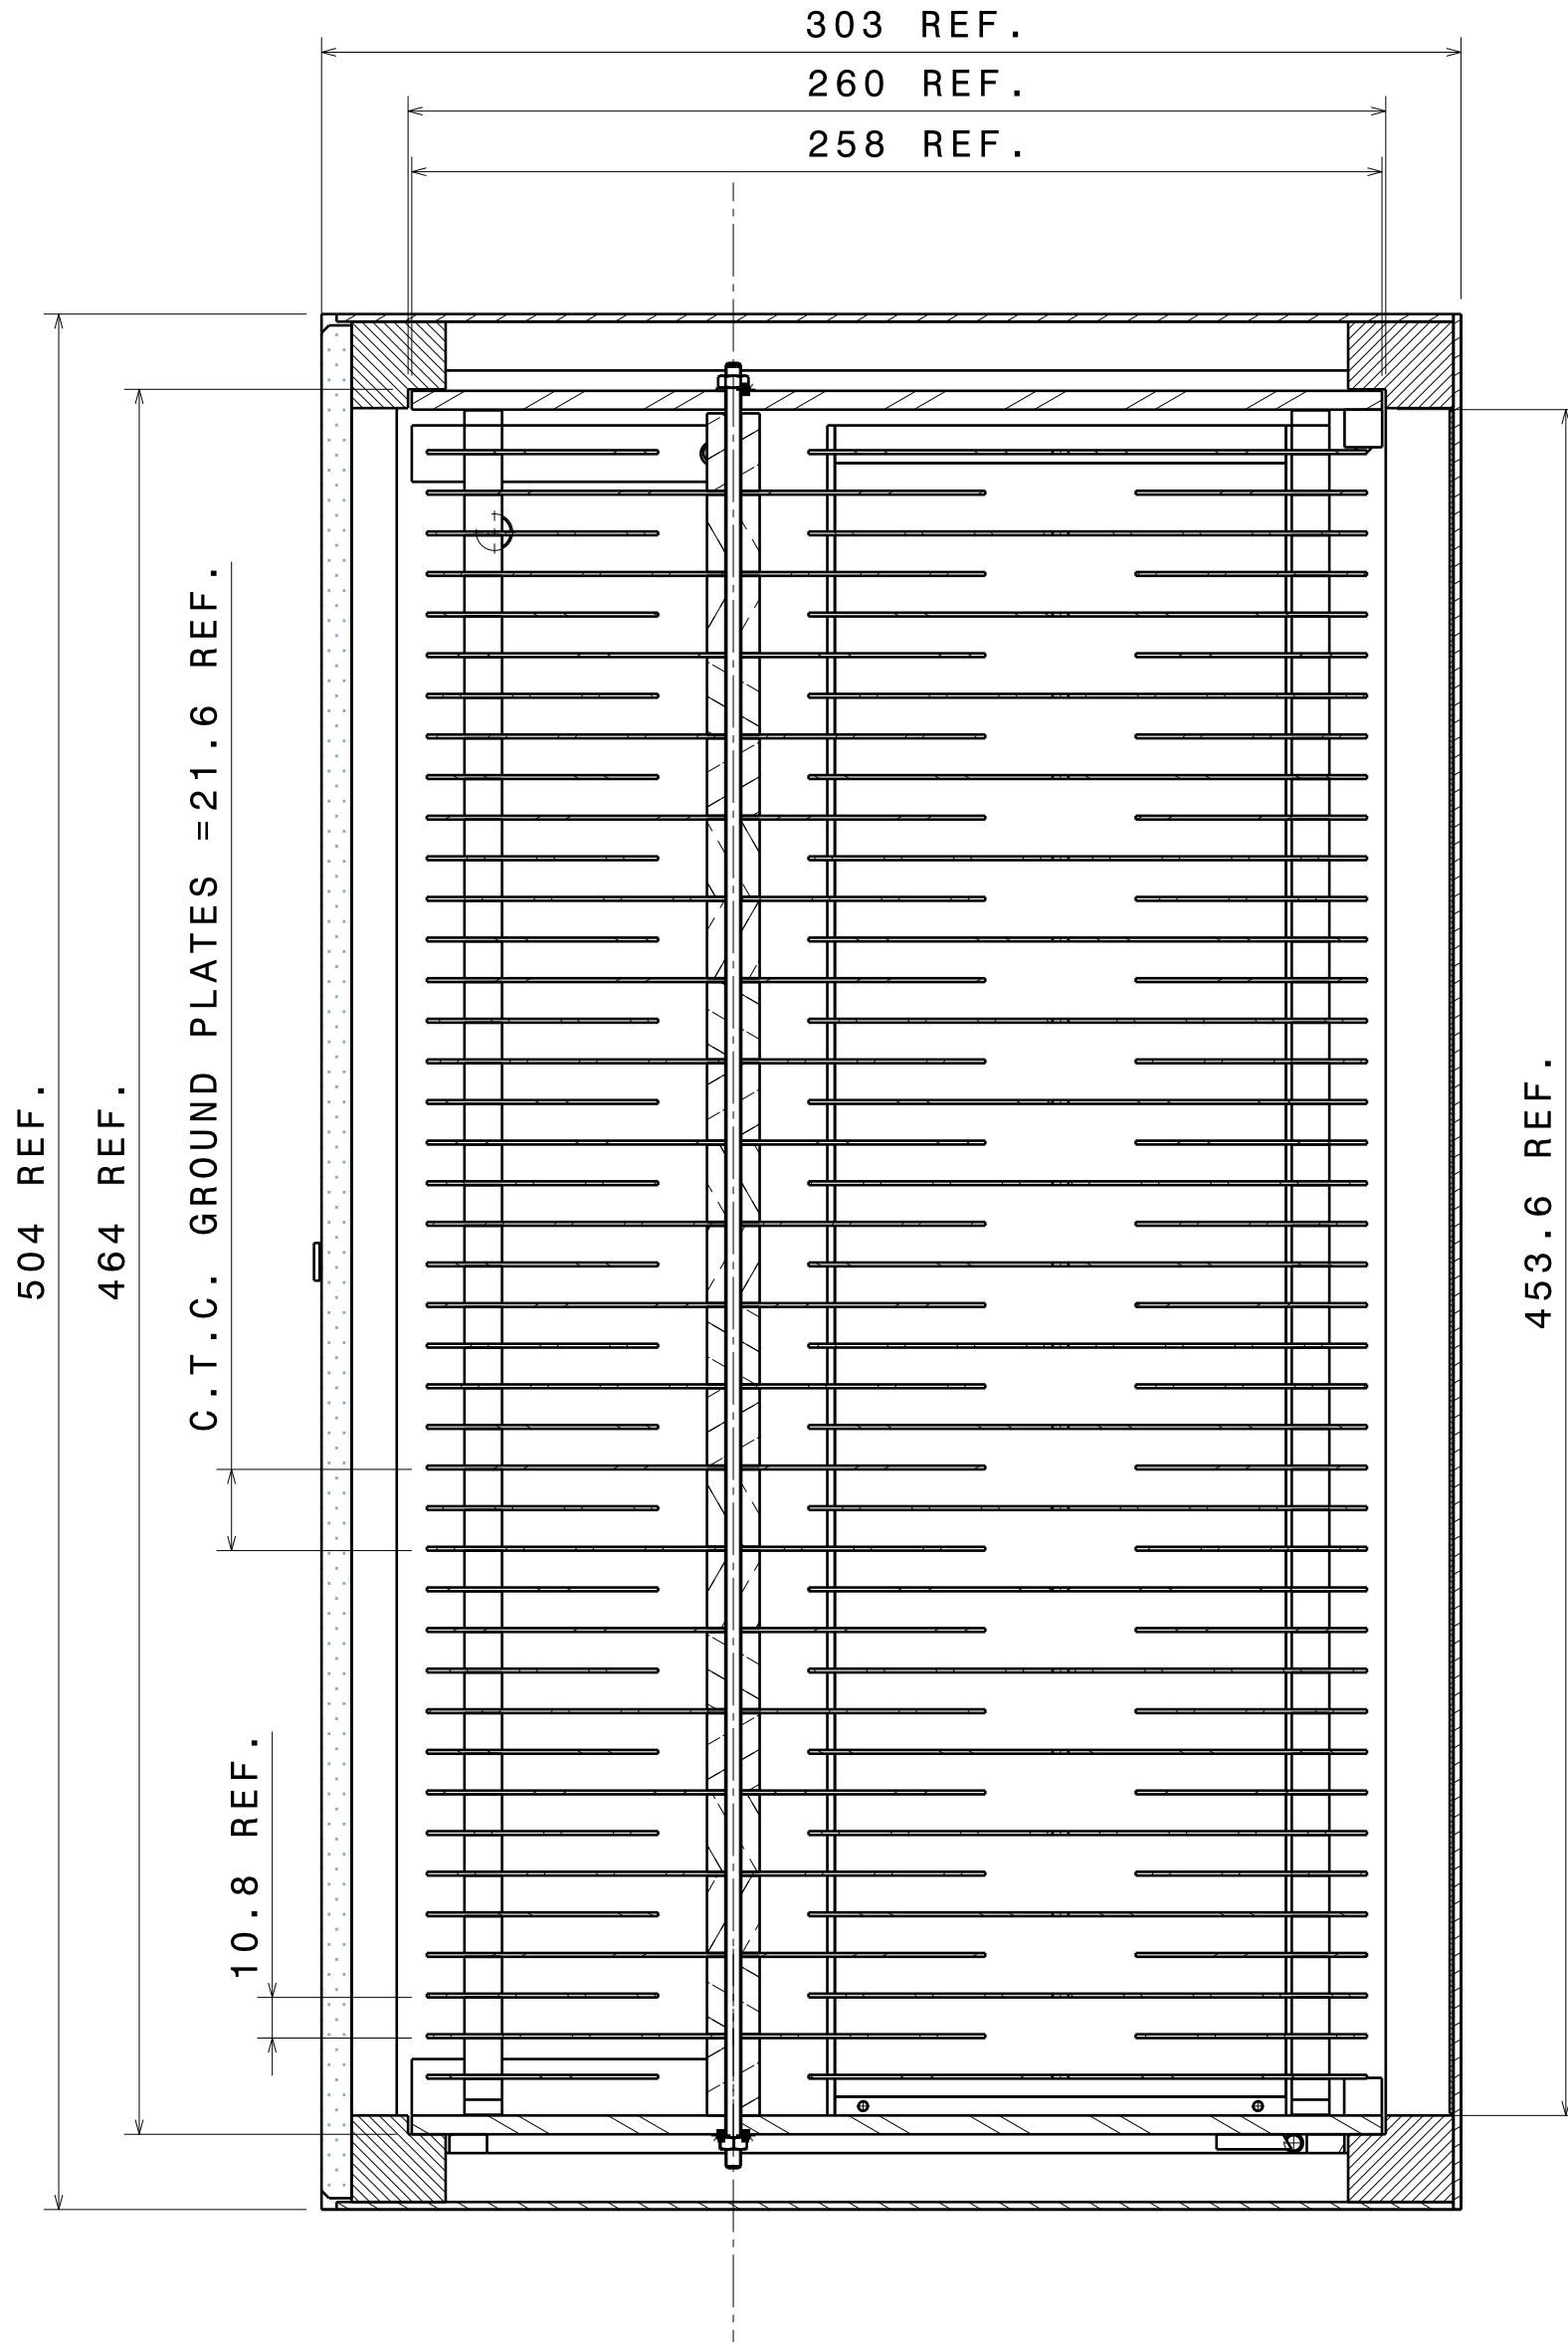


Section view B-B
Scale: 1:2

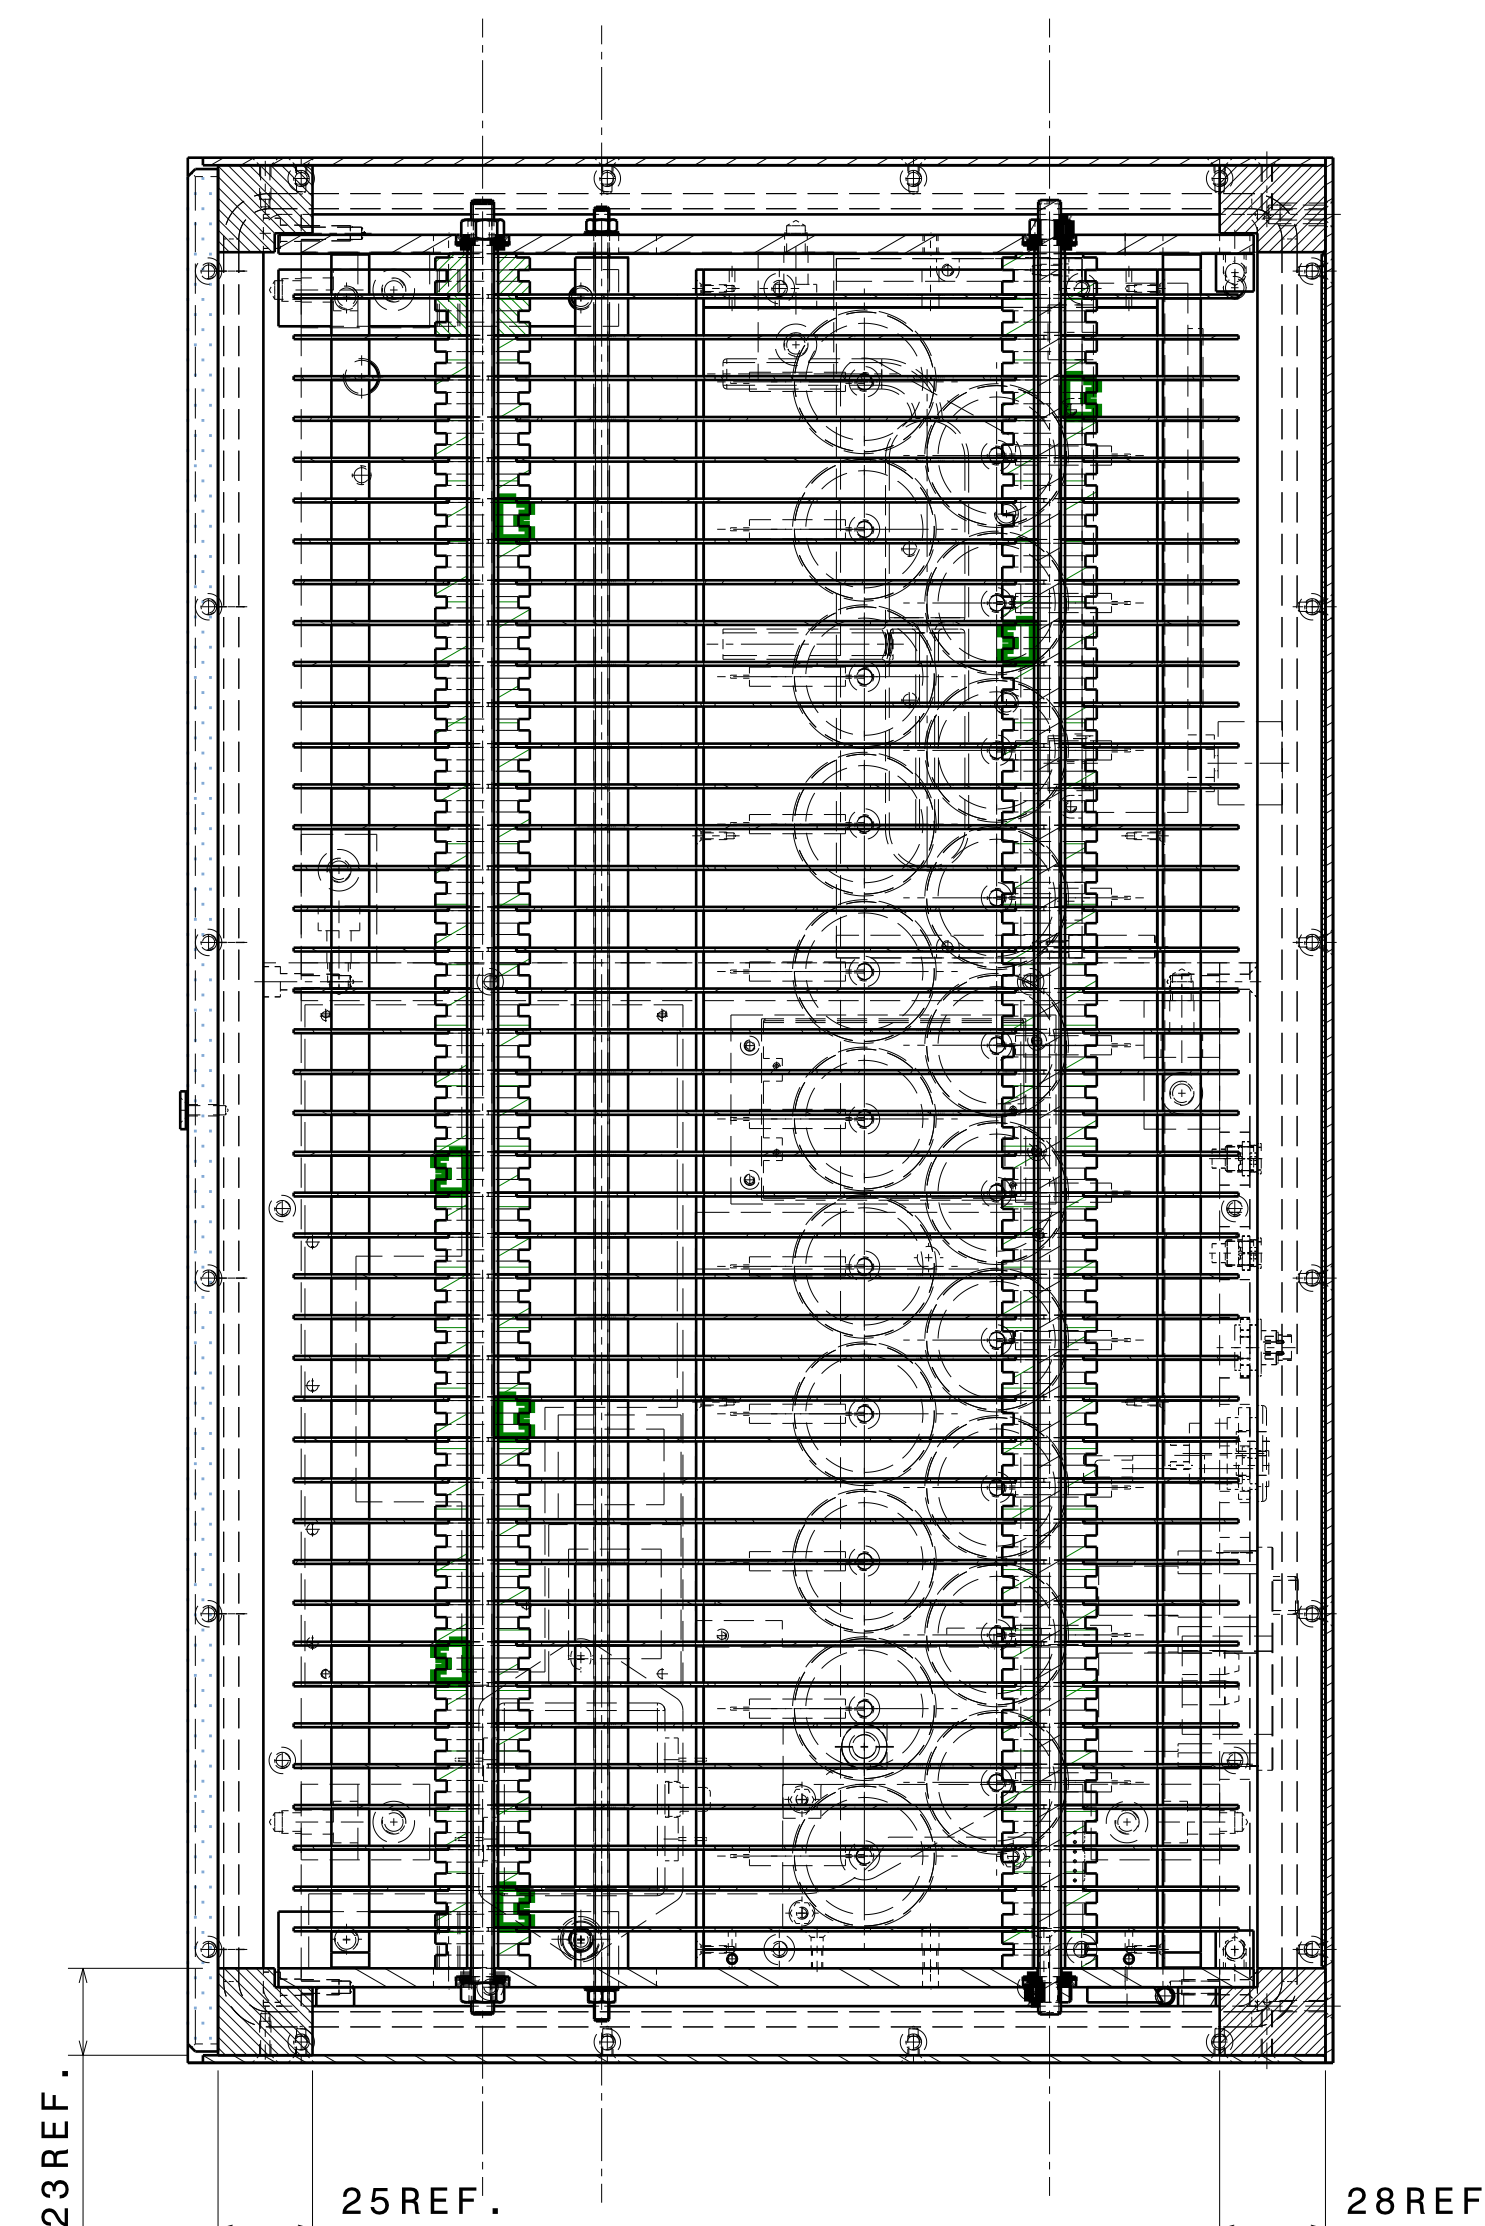


Section view C-C
Scale: 1:2

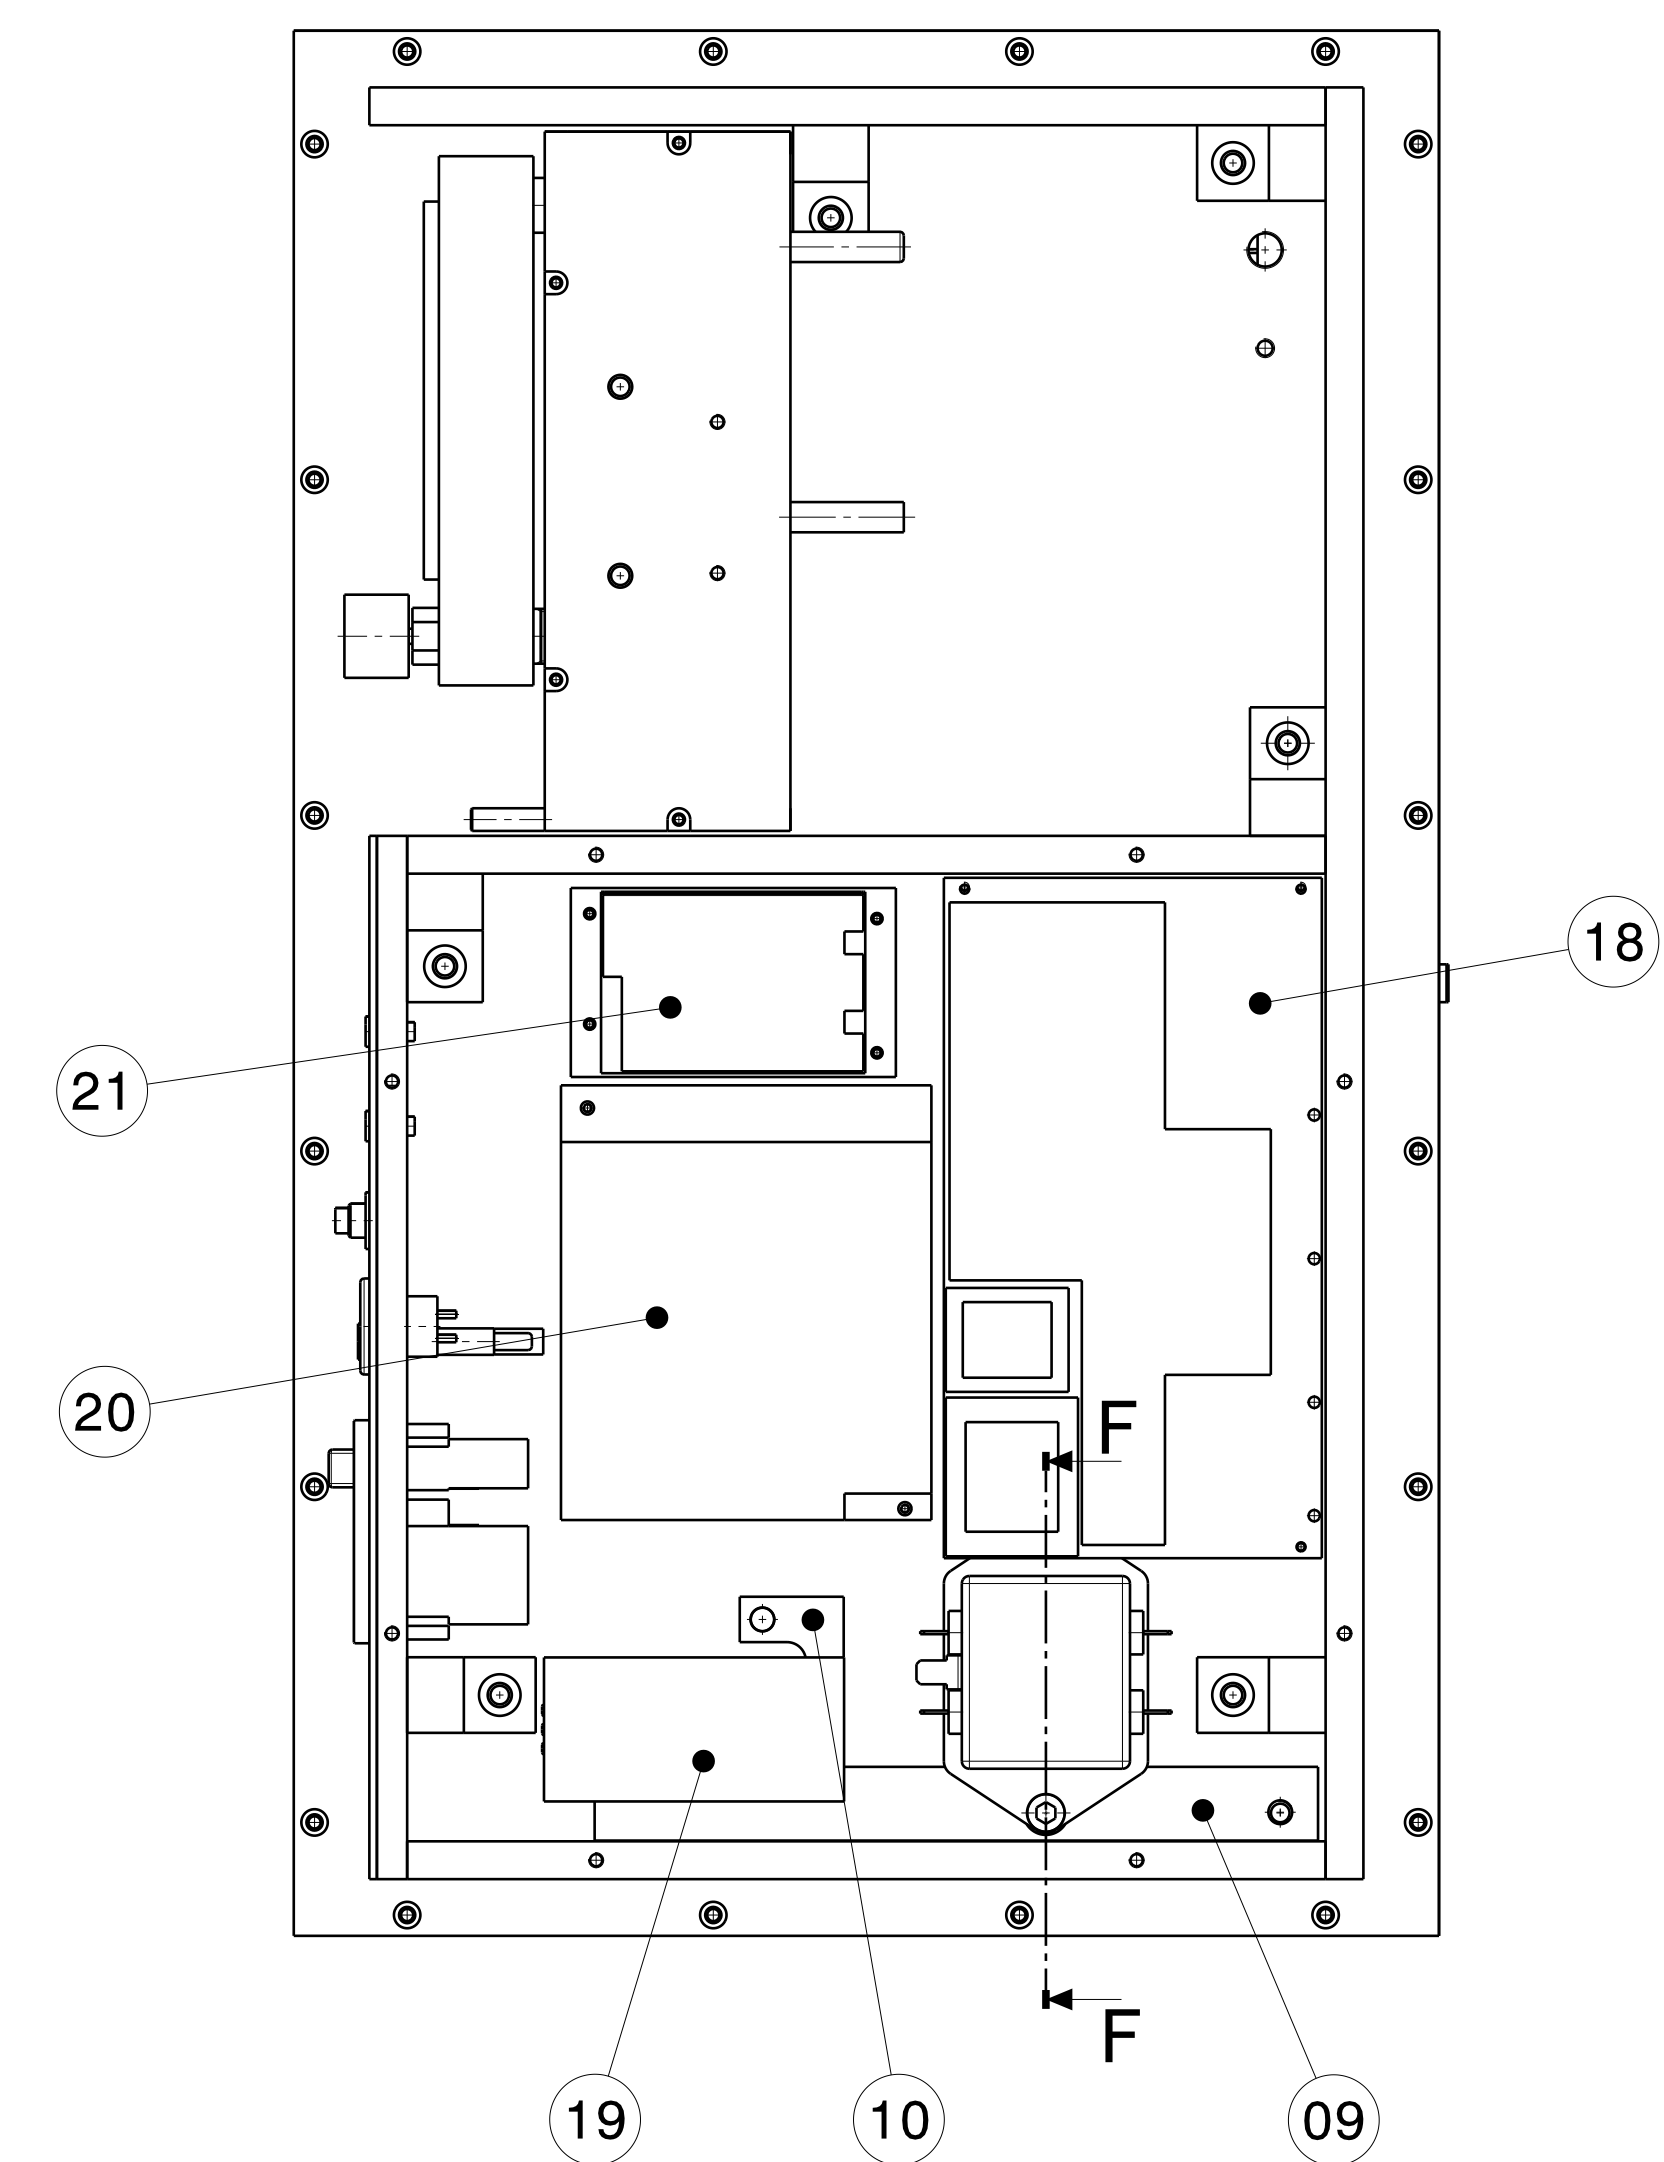


Left view[2]
Scale: 1:2

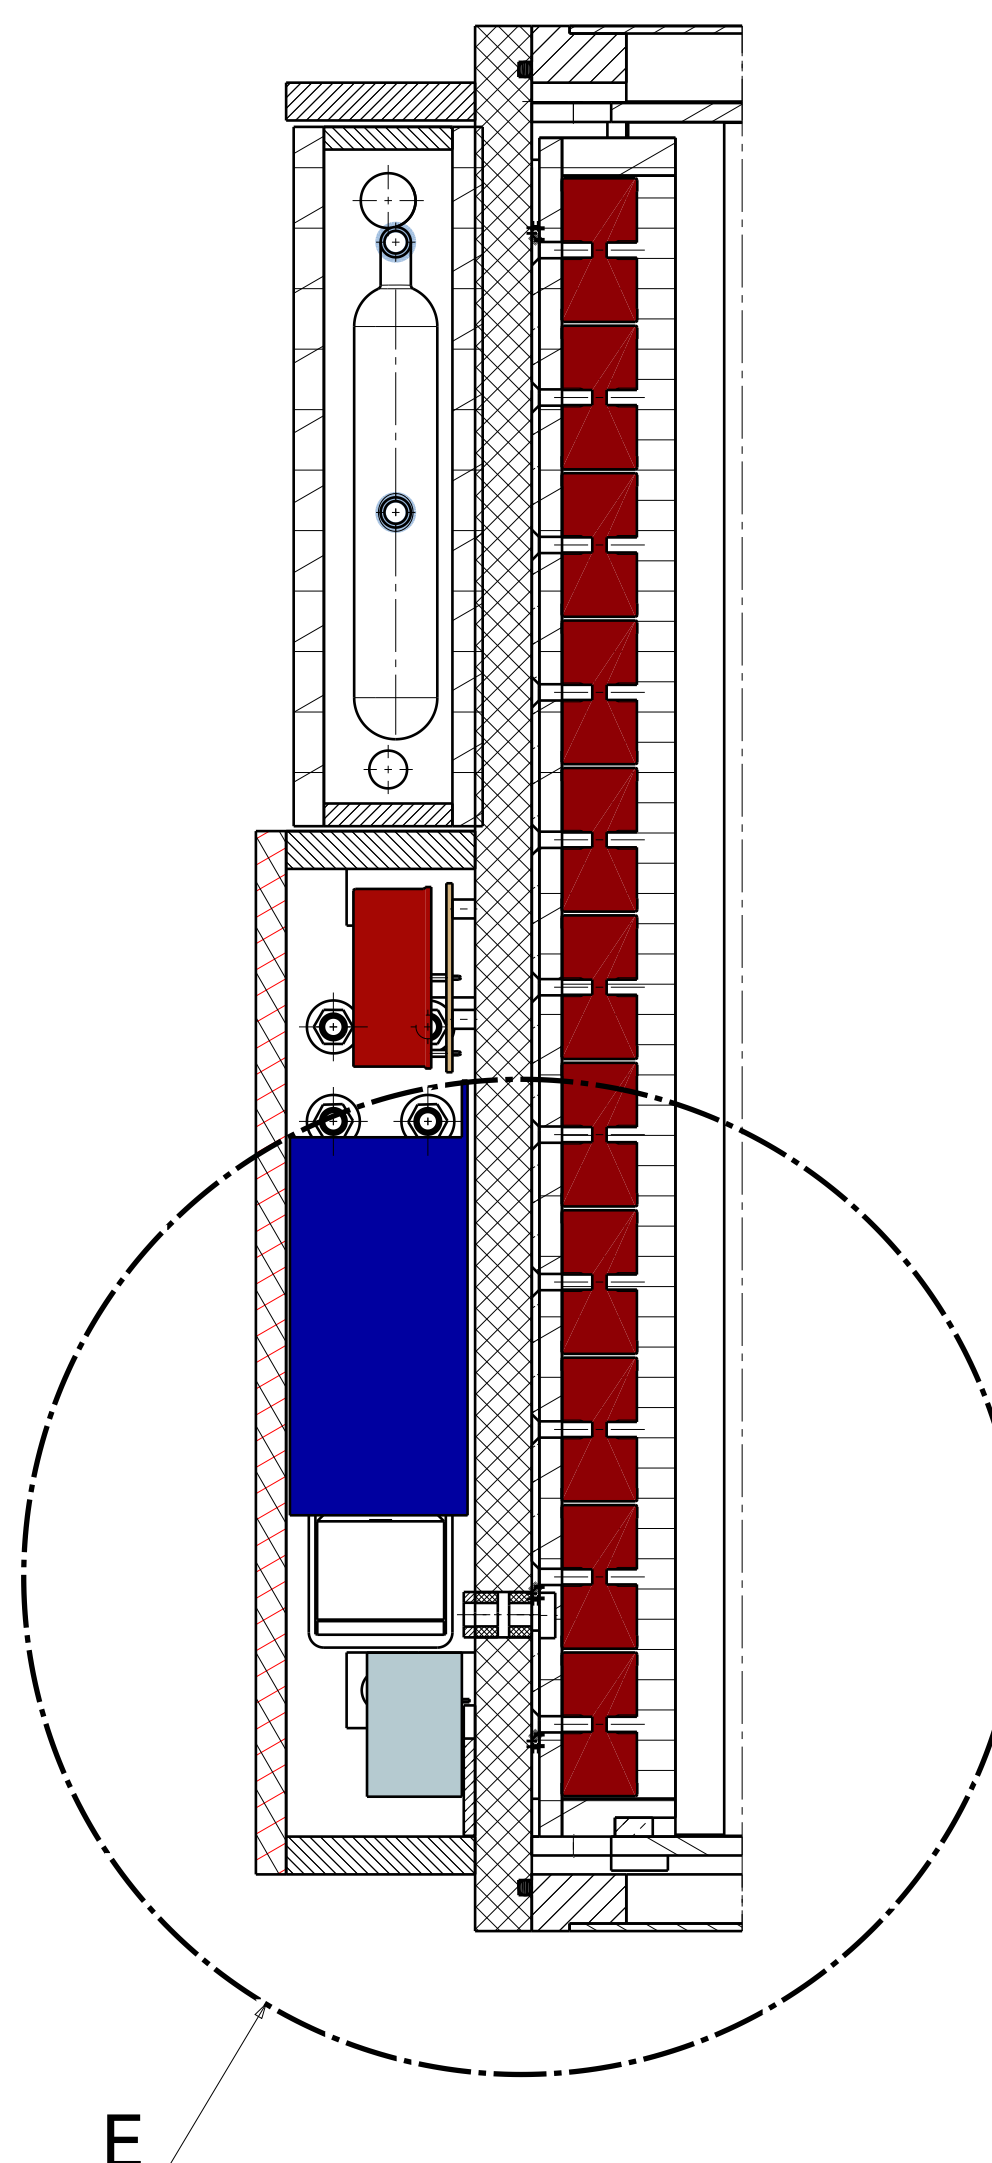


Section view D-D
Scale: 1:2

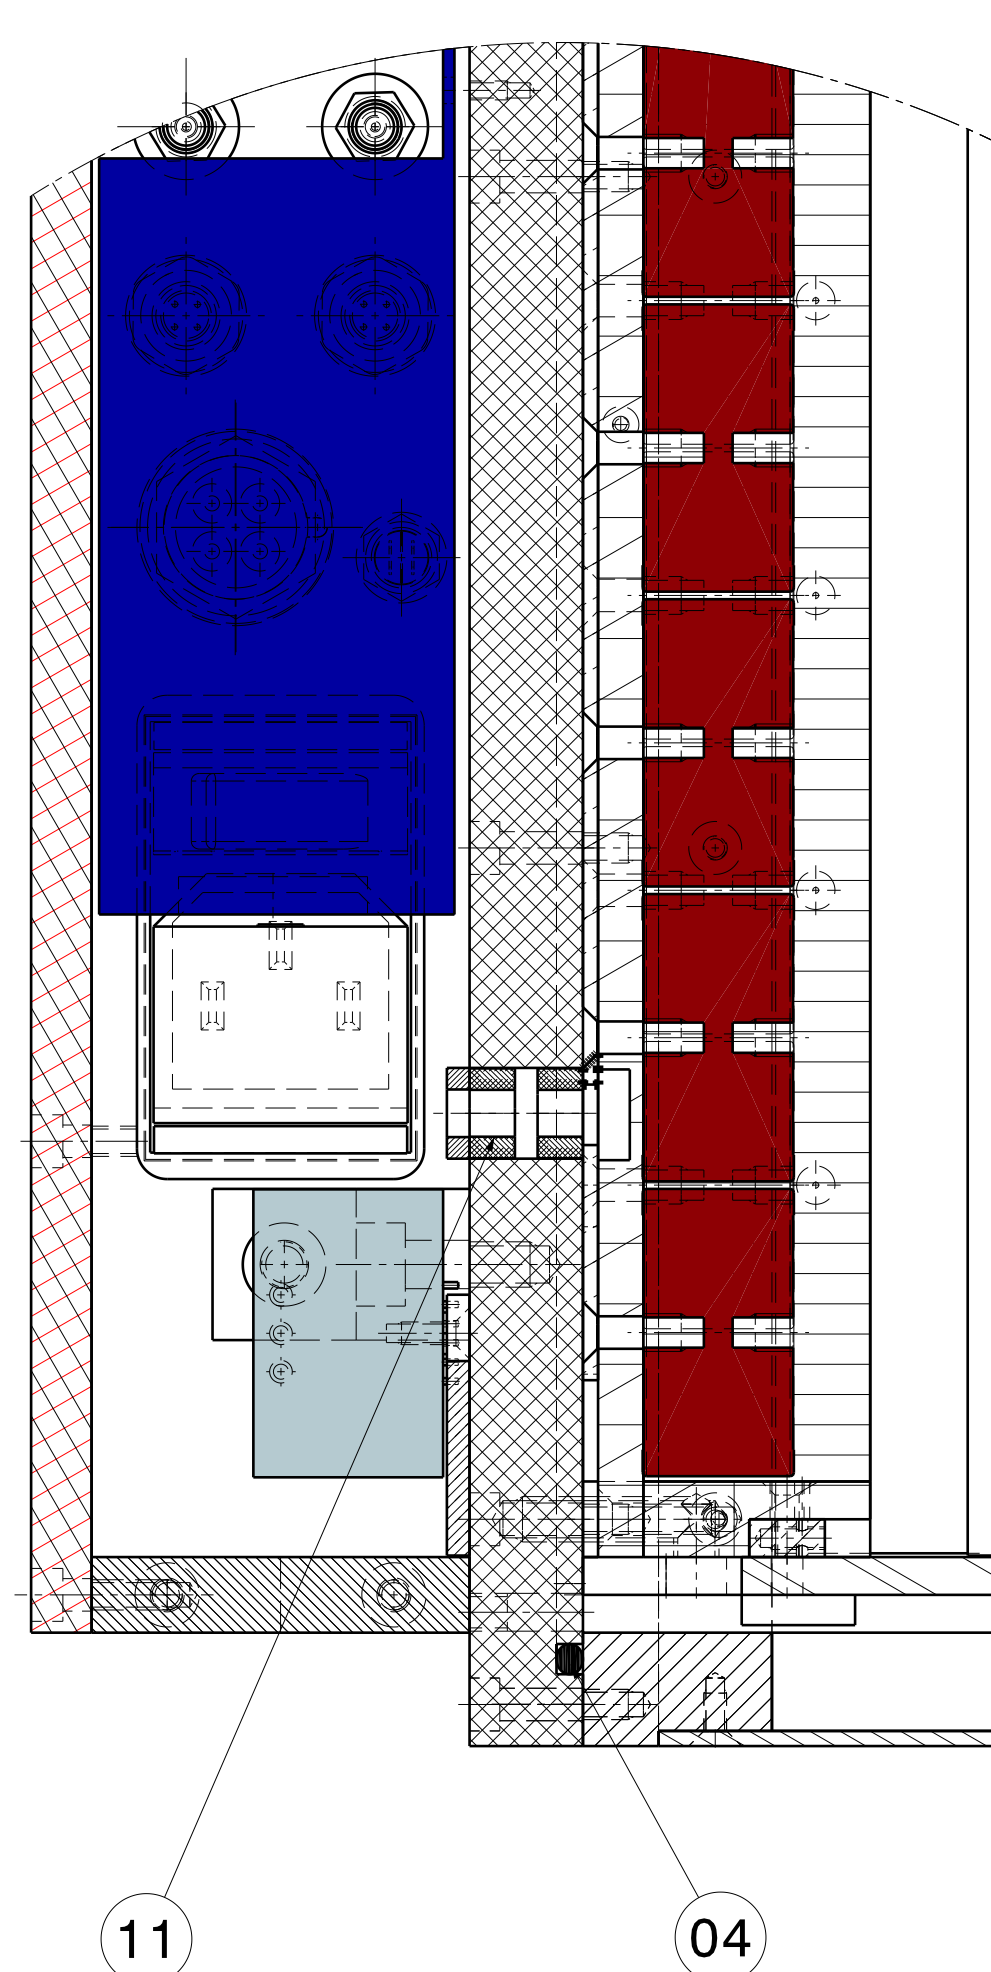

Detail E
Scale: 1:1

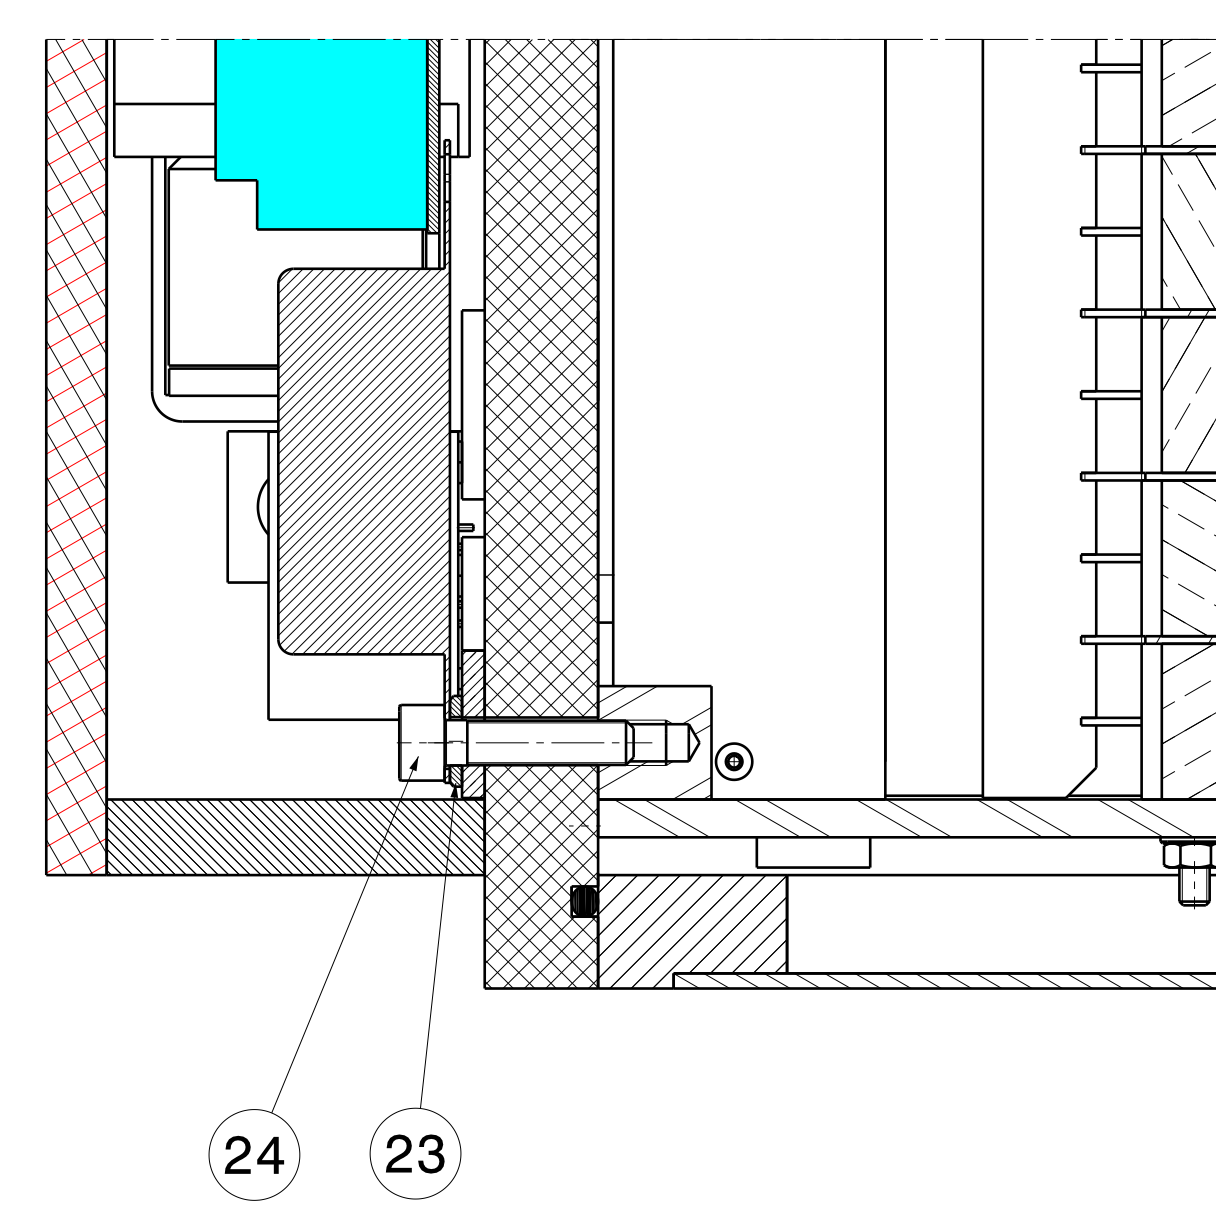

Section view F-F
Scale: 1:1

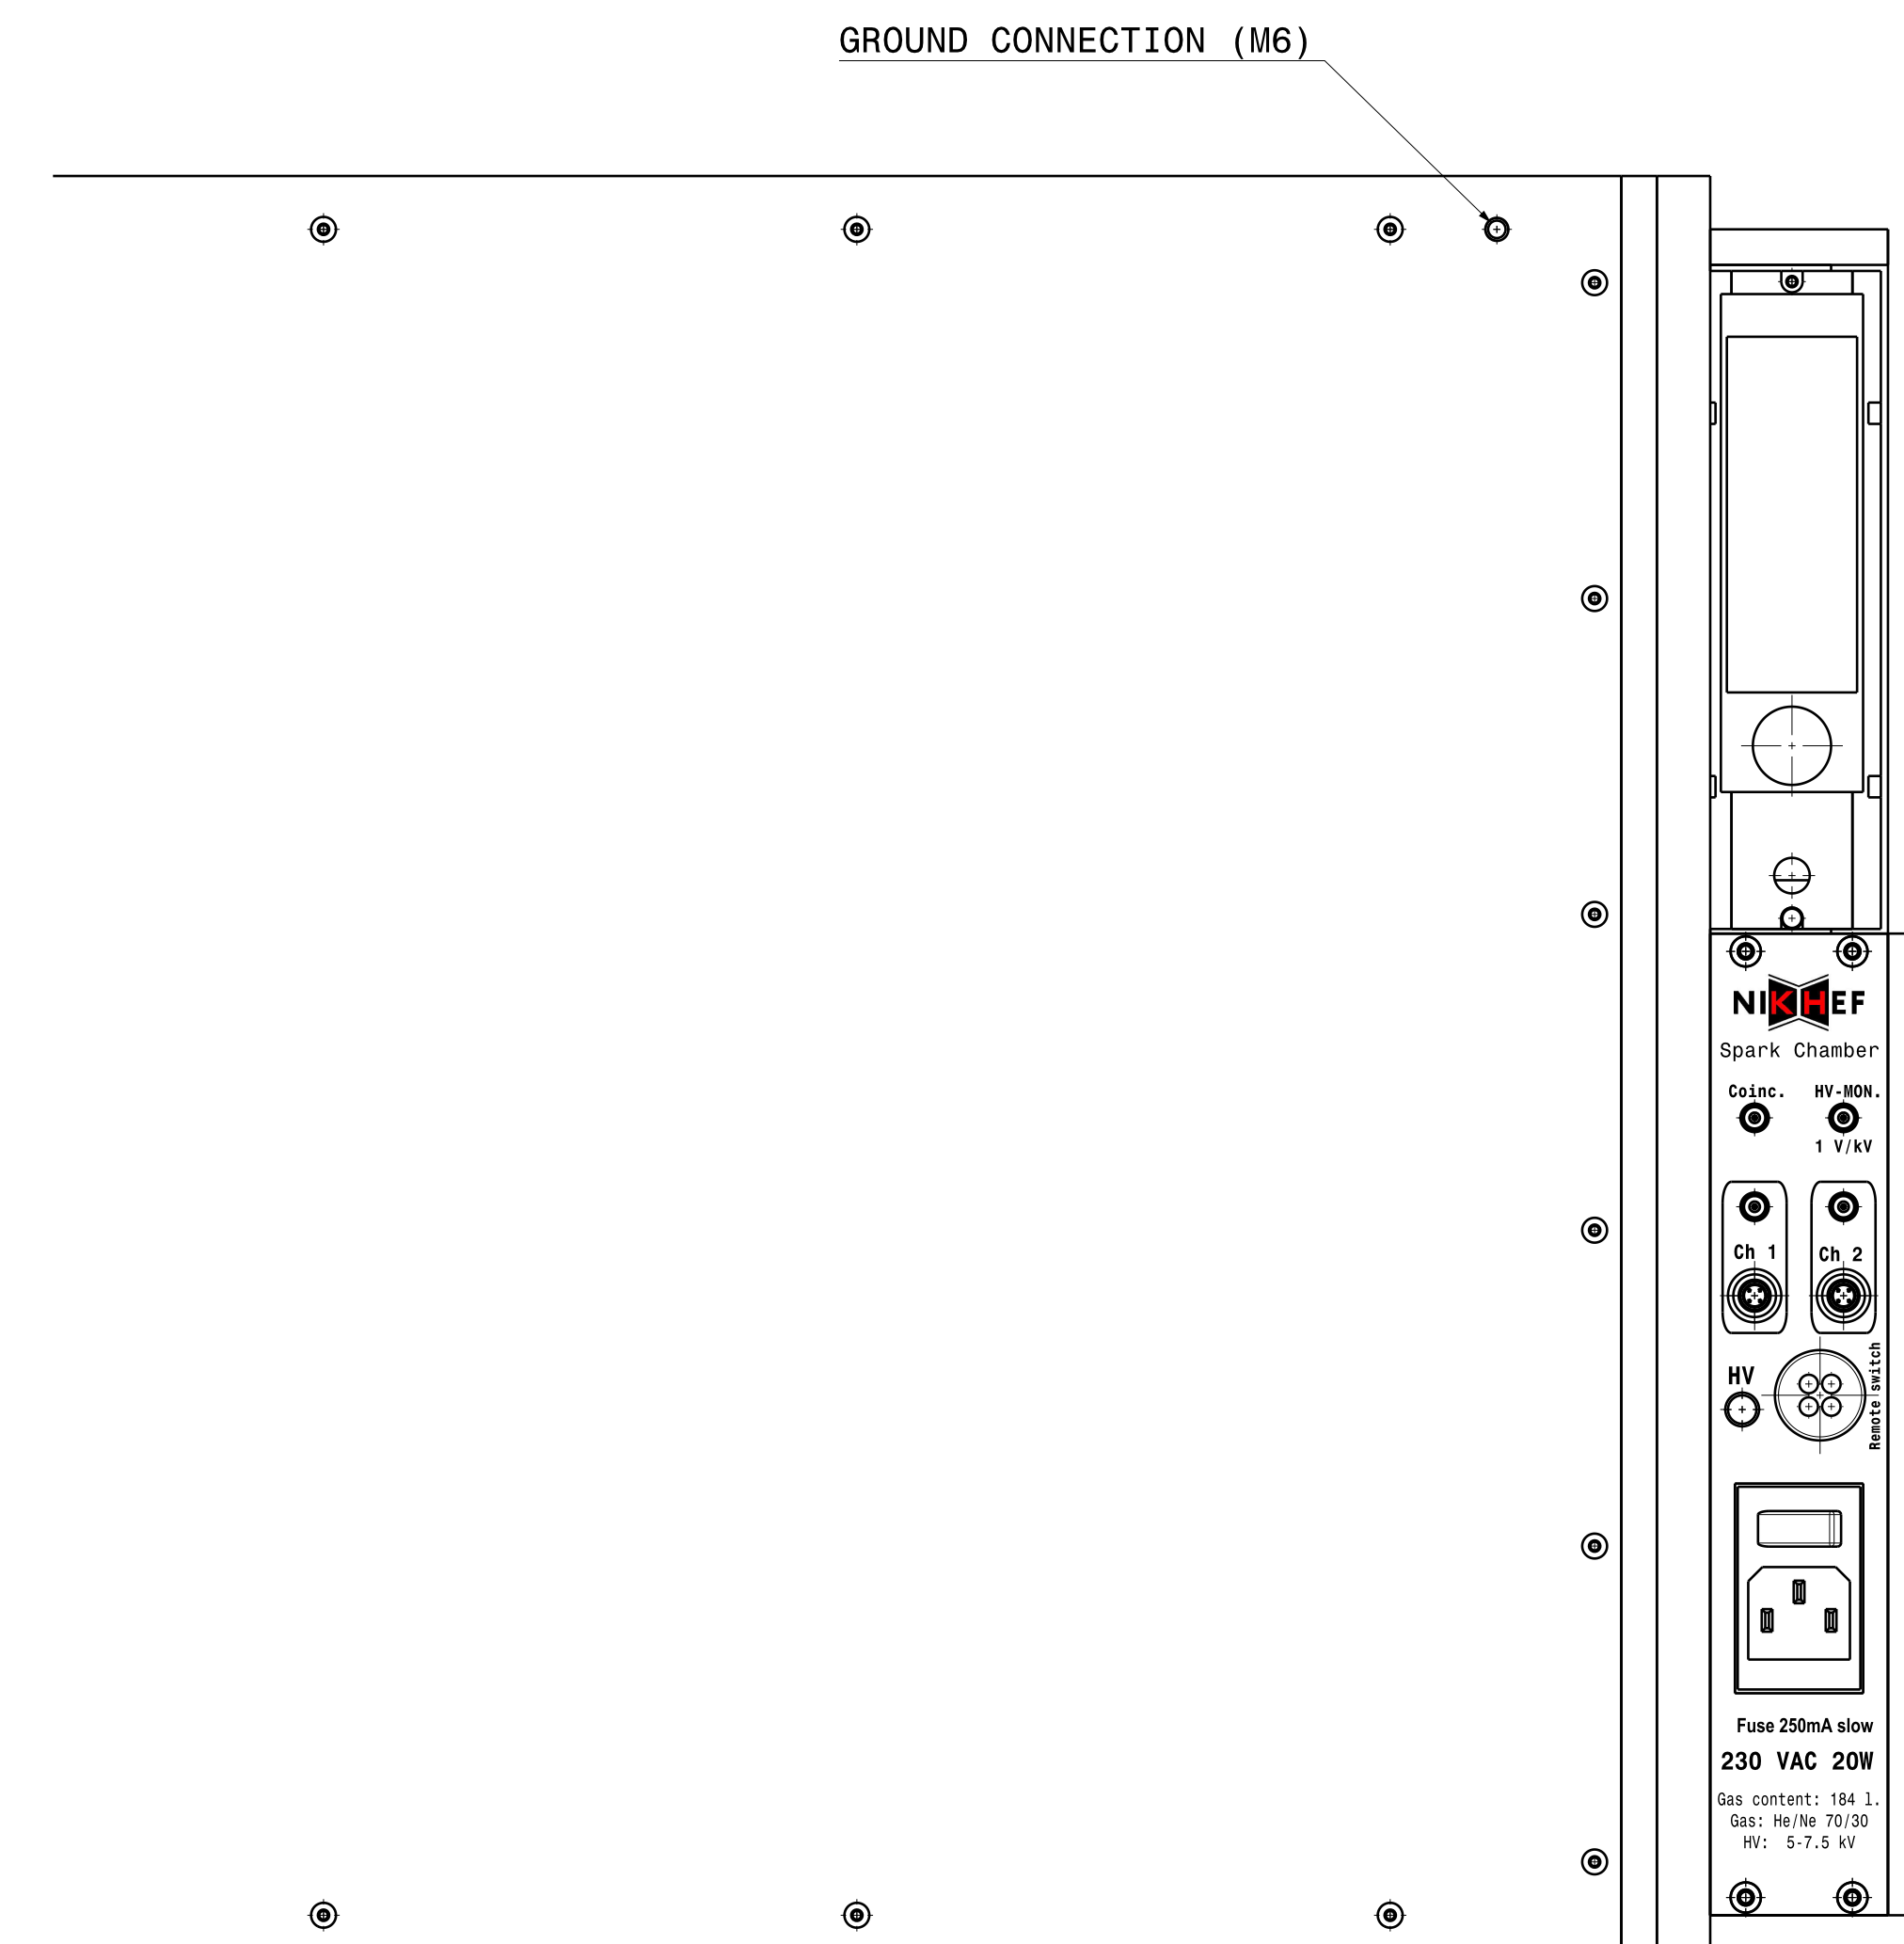

Rear view
Scale: 1:2

MASS: APPROX. 90 KG

AS BUILT

- GENERAL REMARKS:
1. USE OF THIS DEVICE IS ONLY ALLOWED BY AUTHORISED PERSONNEL.
 2. BEFORE USE READ INSTRUCTIONS MANUAL CAREFULLY !
 3. ANY MODIFICATION ON THIS DEVICE, UNLESS OTHERWISE STATED IN THE INSTRUCTIONS MANUAL, IS STRICTLY FORBIDDEN !
 4. IN CASE OF DOUBTS CONCERNING WORKING, SAFETY, ETC. PLEASE CONTACT THE SUPPLIER !