




Front view
Scale: 1:1



Section view A-A
Scale: 1:1

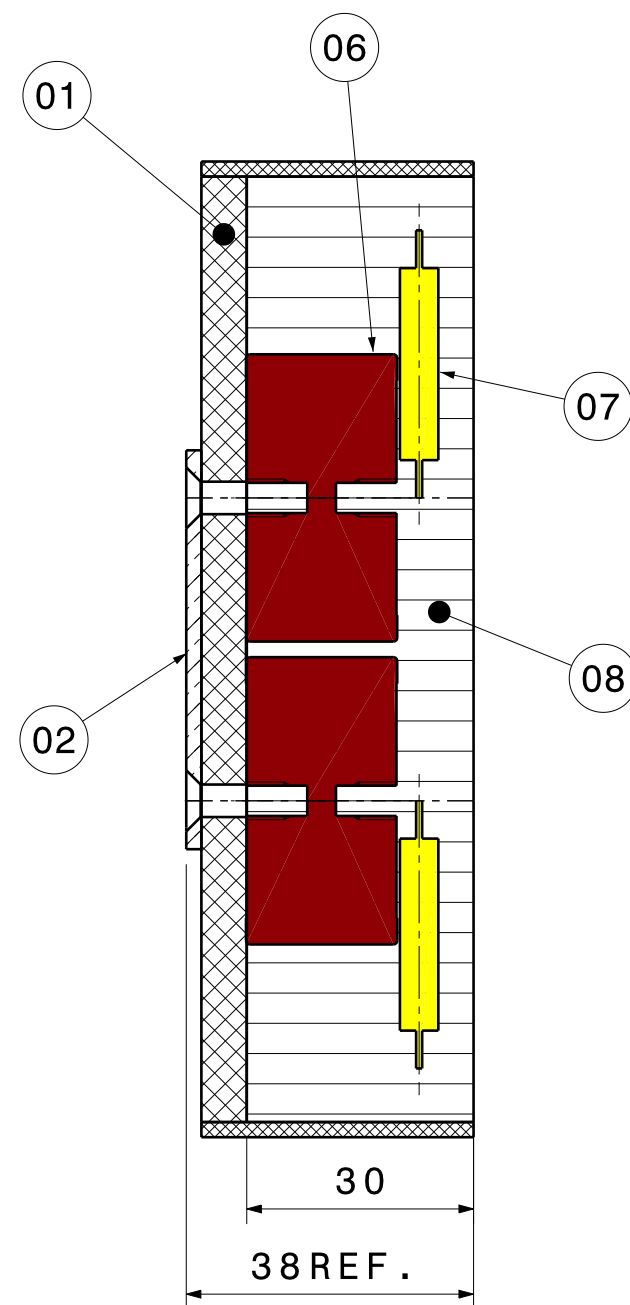

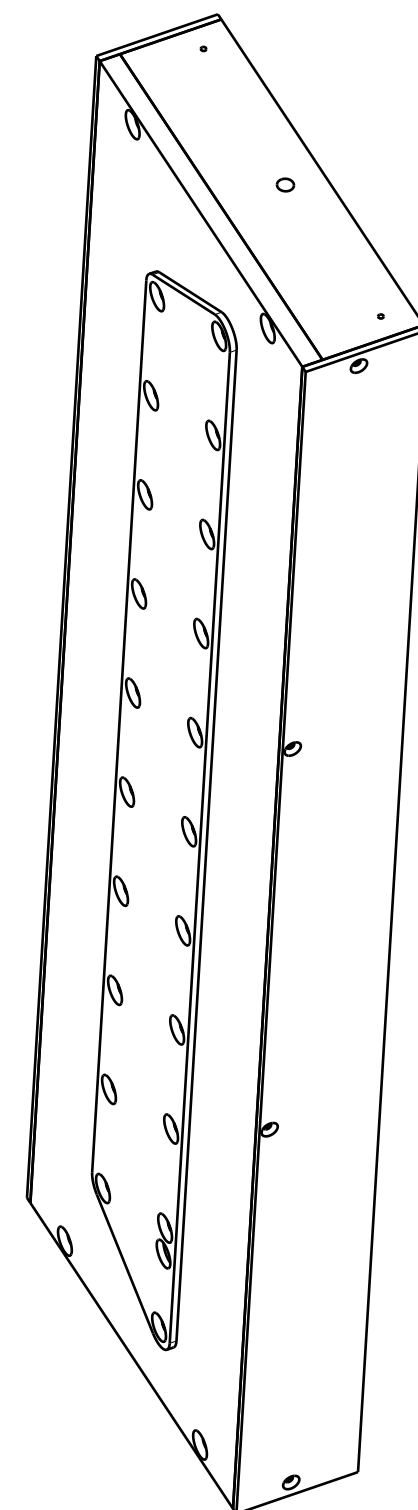


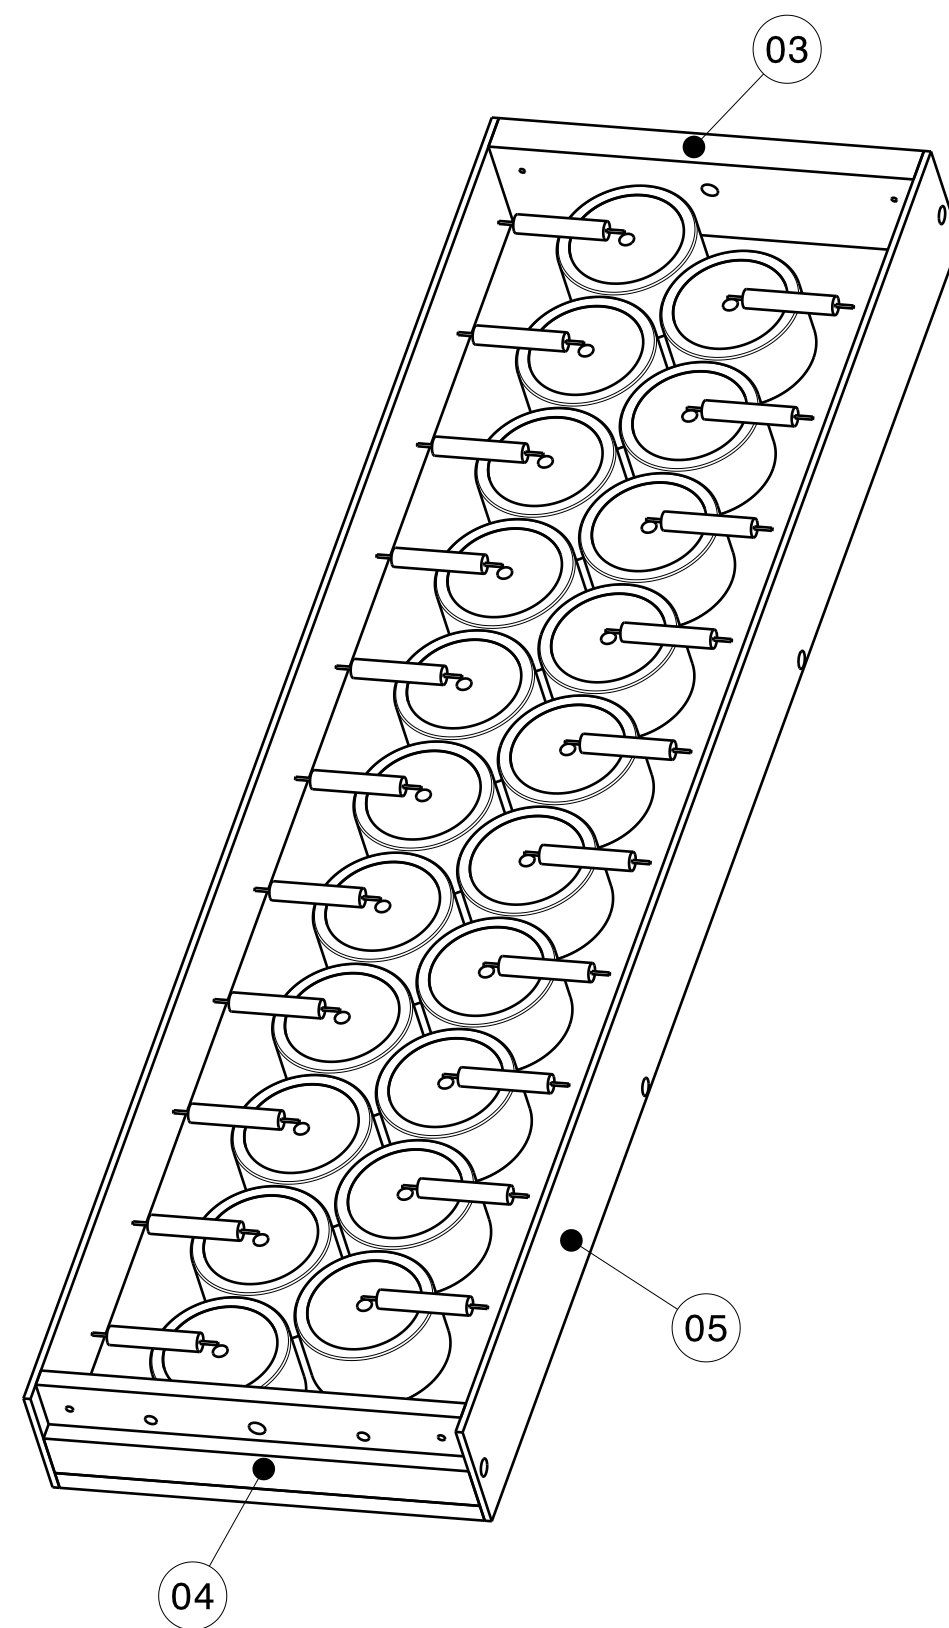Isometric view
Scale: 1:2



Isometric view
Scale: 1:2

AS BUILT
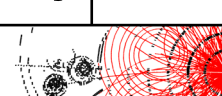
| | | | | |
|--|--|---|---|------------------|
| General tolerances unless otherwise stated according to :ISO-2768-mK-E Geometrical tolerances unless otherwise stated according to:ISO-8015-E Roughness unless otherwise stated according to :ISO-1302 | | | | |
| Project: R&D Spark Chamber | | Units: mm | Date: 28/09/2010 | Revision: A |
| Top folder: Large Spark Chamber | | Size: A2 | Engineer: A. Korporaal | |
| Name: | |  | Checked: A. Korporaal | |
| Capacitor Plate Ass'y | | | Item number: AA0266 | Status: Released |
|  National Institute for Subatomic Physics Science Park 105, 1098XG Amsterdam | |  | Nikhef number: 40091 -ME- 00540 | |
| | | | This drawing may not be used for commercial purposes without written authorisation. | |