


Bottom view (1:2)

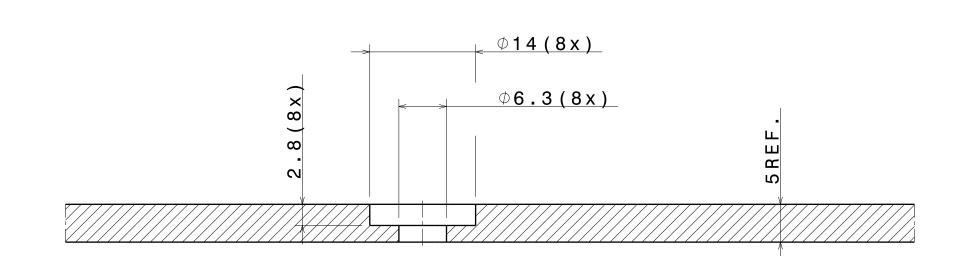

Section view A-A (2:1)

AS BUILT

Units: mm Size:	Date: 22/09/2010	Revision: A
Size:		
	<sup>Engineer:</sup> A. Korpora	al
	<sup>Checked:</sup> A. Korporaal	
	Item number:	Status:
	AA0265	Released
	Nikhef number: 40091-N	ME-00538
		Item number:  AA0265  Nikhef number: