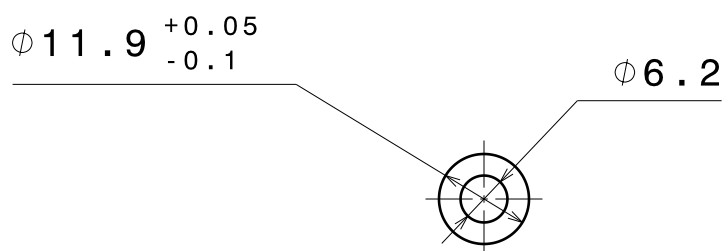
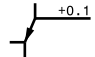
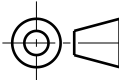

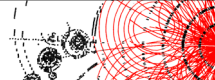


Top view
Scale: 1:1



Front view
Scale: 1:1

AS BUILT

General tolerances unless otherwise stated according to :ISO-2768-mK-E Geometrical tolerances unless otherwise stated according to:ISO-8015-E Roughness unless otherwise stated according to :ISO-1302			Material: Brass	
Project: R&D Spark Chamber		Units: mm	Date: 10/02/2010	Revision: A
Library: Large Spark Chamber		Size: A4	Engineer: A. Korporaal	
Name: Hv bus 1			Checked: A. Korporaal	
			Item number: AA0257	Status: Released
 National Institute for Subatomic Physics Science Park 105, 1098XG Amsterdam				Nikhef number: 40091-ME-00155
This drawing may not be used for commercial purposes without written authorisation.				