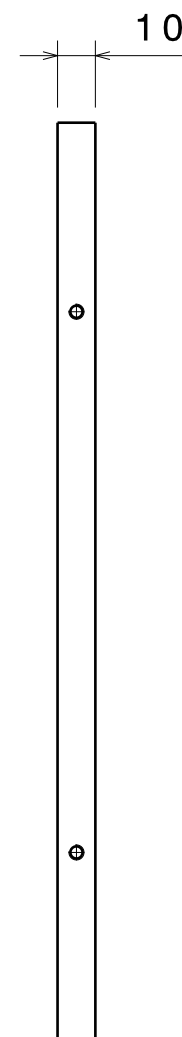


Left view  
Scale: 1:2

Front view  
Scale: 1:2


Right view  
Scale: 1:2

Rear view  
Scale: 1:2




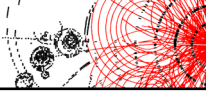


Bottom view  
Scale: 1:2

Isometric view  
Scale: 1:2

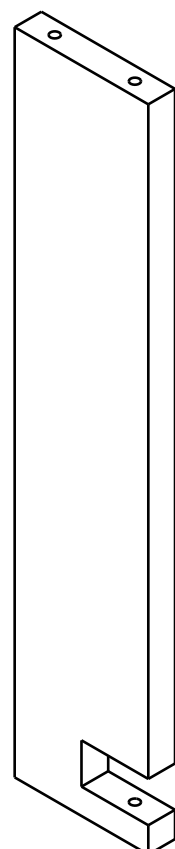

AS BUILT

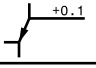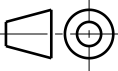General tolerances unless otherwise stated according to :ISO-2768-mK-E Geometrical tolerances unless otherwise stated according to:ISO-8015-E Roughness unless otherwise stated according to :ISO-1302		 +0.1		Material: PVC (Black)	
Project: R&D Spark Chamber		Units: mm	Date: 15/02/2010		Revision: A
Library: Large Spark Chamber		Size: A3	Engineer: A. Korpelaar		
Name: Service Housing Plate 4				Checked: A. Korpelaar	
				Item number: AA0301	Status: Released
 National Institute for Subatomic Physics Science Park 105, 1098XG Amsterdam				Nikhef number: 40091-ME-00185	
This drawing may not be used for commercial purposes without written authorisation.					