



Left view  
Scale: 1:2


Front view  
Scale: 1:2

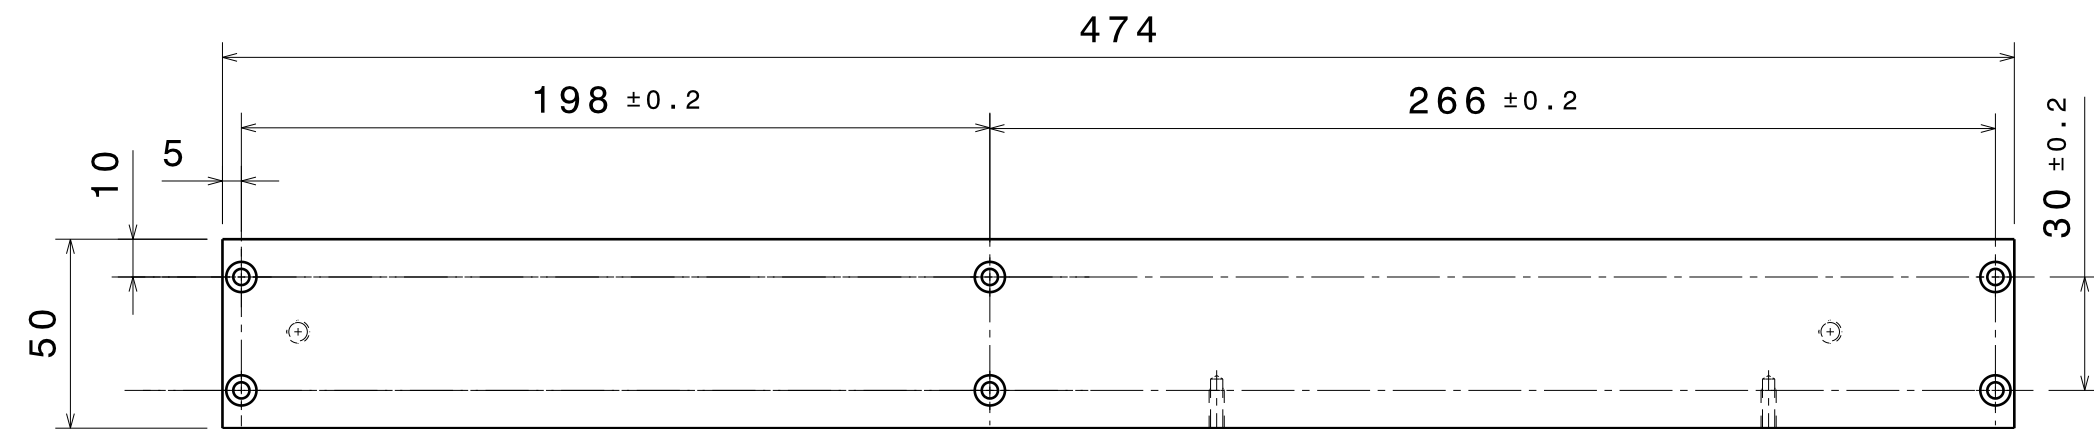


Right view  
Scale: 1:2

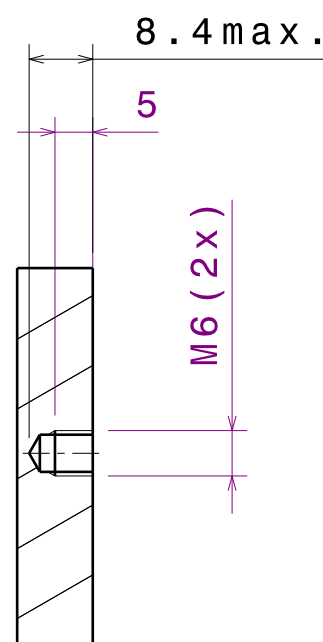


Section view A-A  
Scale: 1:1

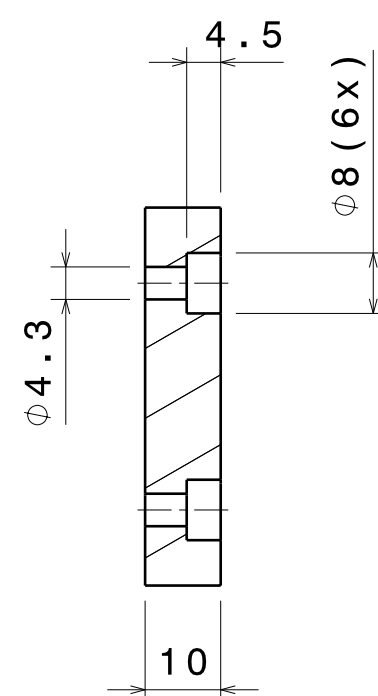


Section view B-B  
Scale: 1:1

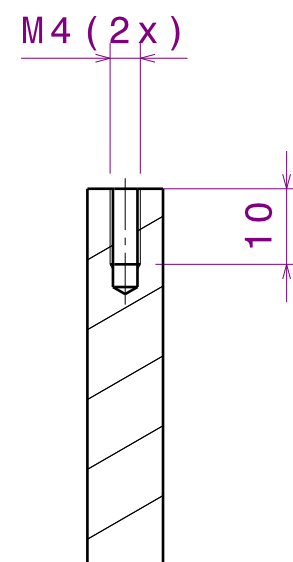

Section view C-C  
Scale: 1:1


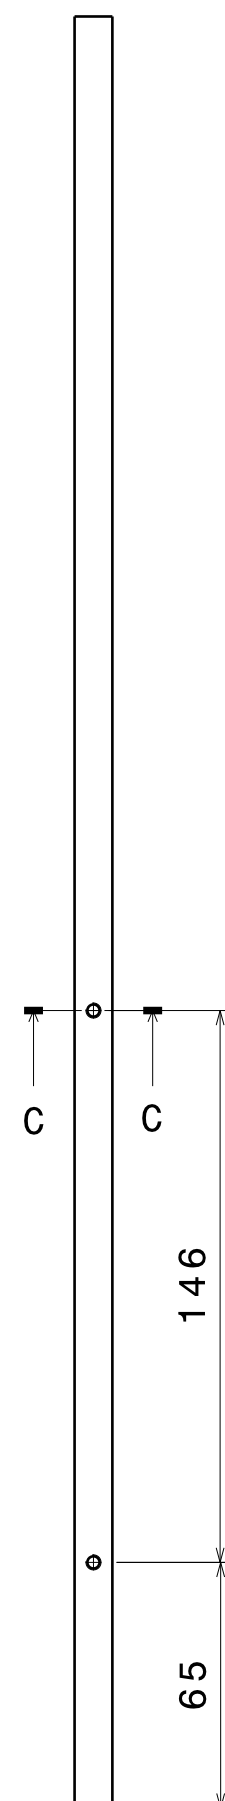

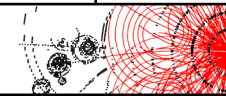


Bottom view  
Scale: 1:2

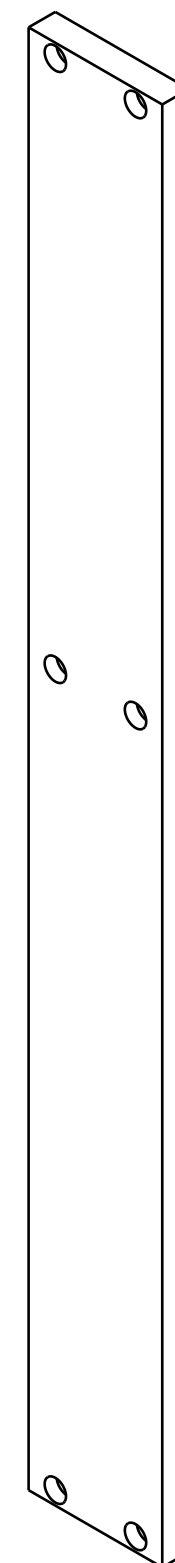

Isometric view  
Scale: 1:2

AS BUILT

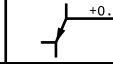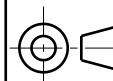General tolerances unless otherwise stated according to :ISO-2768-mK-E Geometrical tolerances unless otherwise stated according to:ISO-8015-E Roughness unless otherwise stated according to :ISO-1302			Material: PVC (Black)	
Project: R&D Spark Chamber		Units: mm	Date: 15/02/2010	Revision: A
Library: Large Spark Chamber		Size: A2	Engineer: A. Korporaal	
Name: Service Housing Plate 2			Checked: A. Korporaal	
Item number: AA0298			Status: Released	
 National Institute for Subatomic Physics Science Park 105, 1098XG Amsterdam		 Nikhef number: 40091-ME-00183		
This drawing may not be used for commercial purposes without written authorisation.				