


Section view A-A



**AS BUILT**

General tolerances unless otherwise stated according to :ISO-2768-mK-E  
Geometrical tolerances unless otherwise stated according to:ISO-8015-E  
Roughness unless otherwise stated according to :ISO-1302

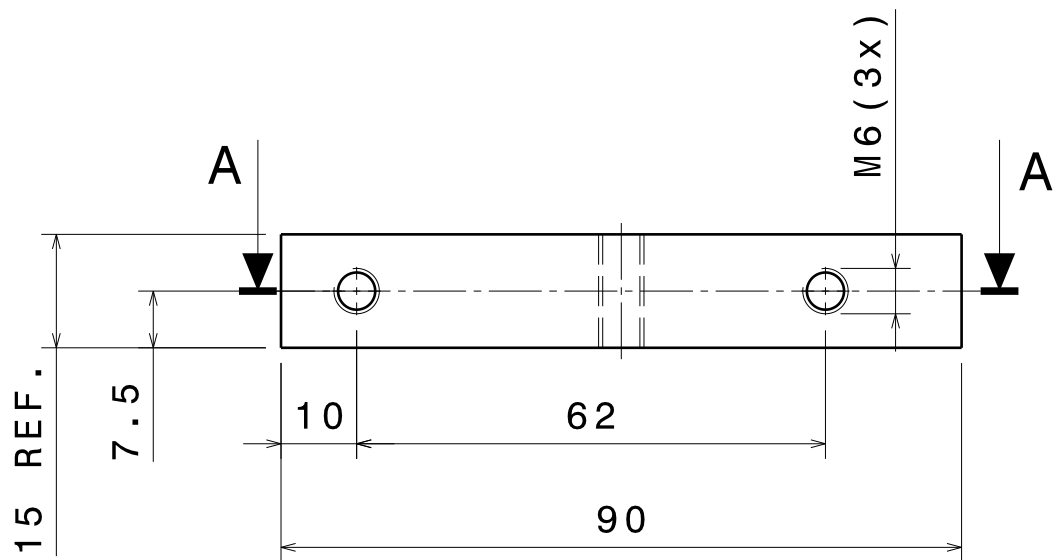

Material:

Aluminium

Project: R&D Spark Chamber

Units: mm

Date: 11/02/2010

Revision: A


Library: Large Spark Chamber

Size: A4

Engineer: A. Korpelaar

Name:

Plate Clamp Ground

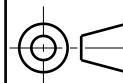


Checked: A. Korpelaar

Item number:  
AA0277

Status:  
Released



National Institute for  
Subatomic Physics  
Science Park 105, 1098XG Amsterdam

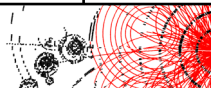

Nikhef number:

40091-ME-00165