


Section view A-A
Scale: 2:1

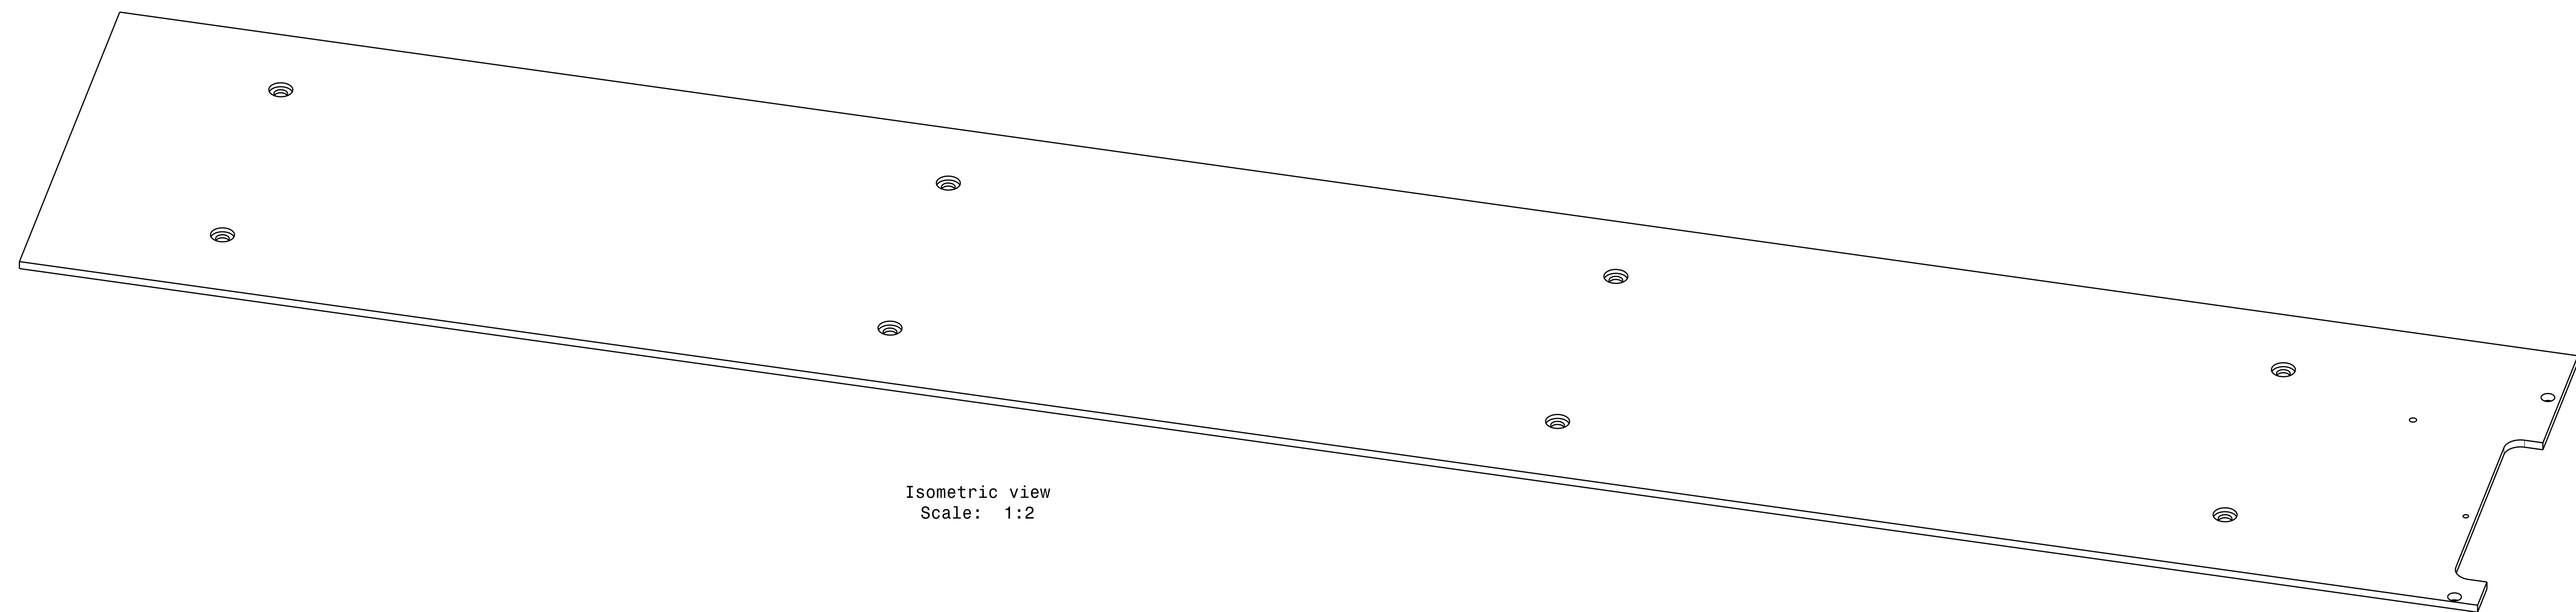

Isometric view
Scale: 1:2

AS BUILT

General tolerances unless otherwise stated according to ISO 2768-MS		Material: ALUMINIUM	
Geometrical tolerances unless otherwise stated according to ISO 1101		Drawn: AG	Date: 11/02/2019
Surface tolerances unless otherwise stated according to ISO 1305		Project: R&D Spark Chamber	Revision: A
Library: Large Spark Chamber		Drawn: AG	Engineer: A. Korporaal
Name: Upper Electrode Plate		Checked: A. Korporaal	Released
Item number: AA0279		Released	
National Institute for Subatomic Physics		Nikhef number: 40091-ME-00167	
Nikhef		This drawing may not be used for commercial purposes without written authorization.	