


Front view
Scale: 1:5

HOLE GROUND CONNECTION

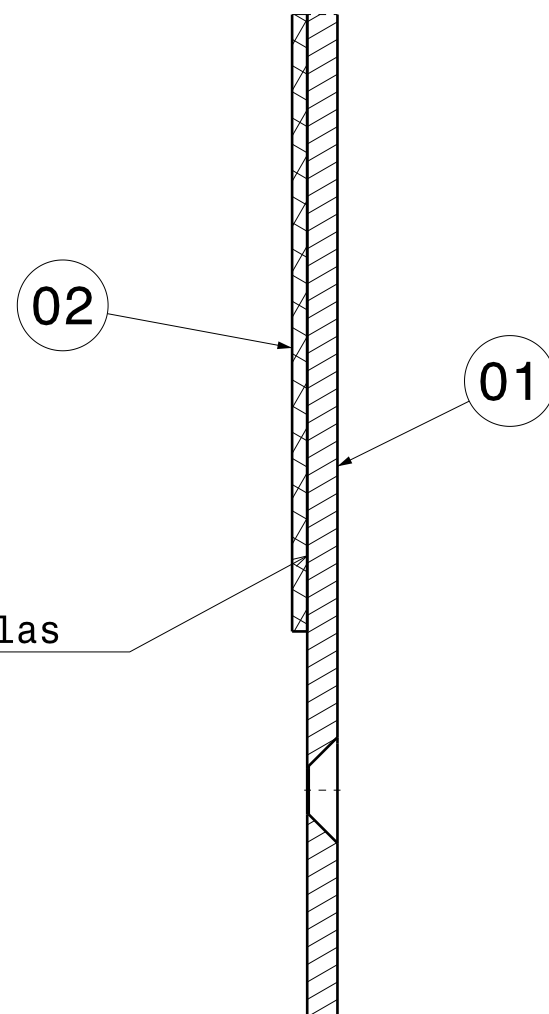

- * Clean/degrease bonding surfaces carefull.
- * Bond with BISON Siliconenkit Transparant voor glas

Section view A-A
Scale: 2:1

AS BUILT

General tolerances unless otherwise stated according to :ISO-2768-mK-E Geometrical tolerances unless otherwise stated according to:ISO-8015-E Roughness unless otherwise stated according to :ISO-1302				
Project: R&D Spark Chamber		Units: mm	Date: 22/09/2010	Revision: A
Library: Large Spark Chamber		Size: A2	Engineer: A. Korporaal	
Name: Back Side Plate Ass'y			Checked: A. Korporaal	Status:
			Item number: AA0250	Released
National Institute for Subatomic Physics Science Park 105, 1098XG Amsterdam			Nikhef number: 40091-ME-00157	
This drawing may not be used for commercial purposes without written authorisation.				