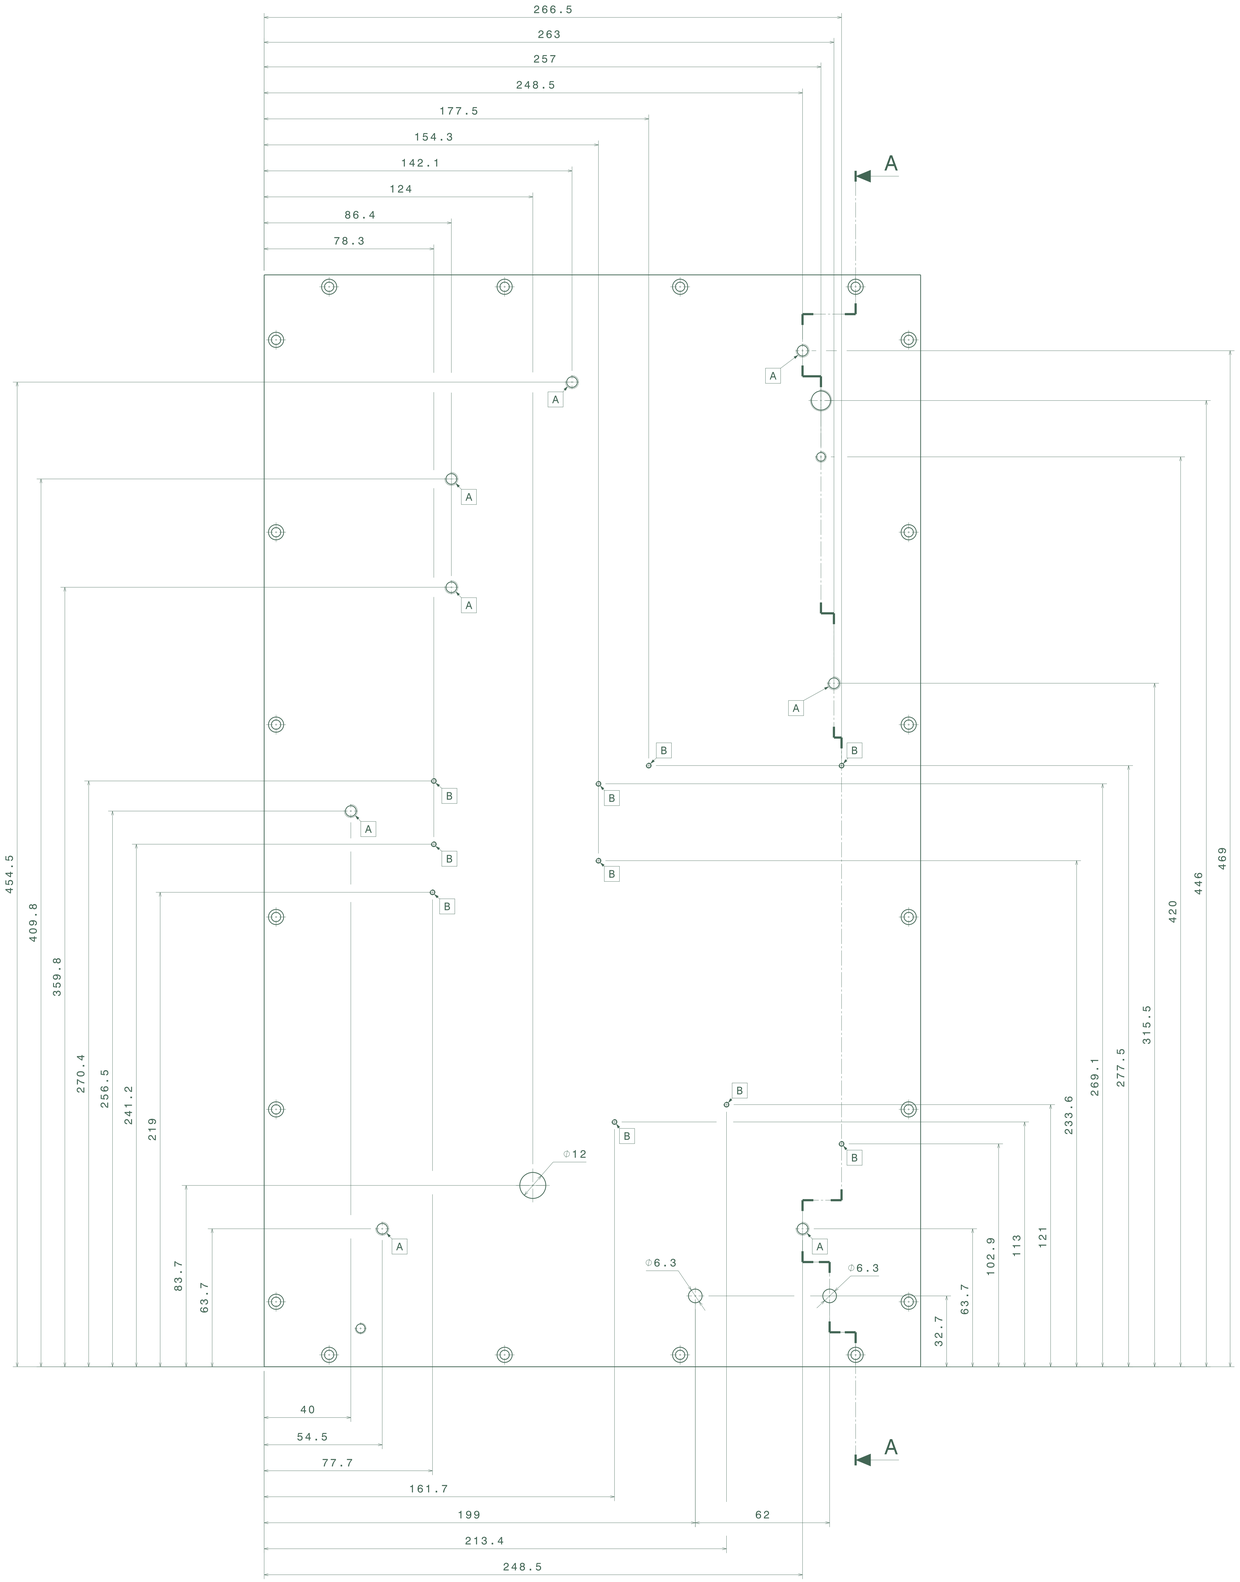

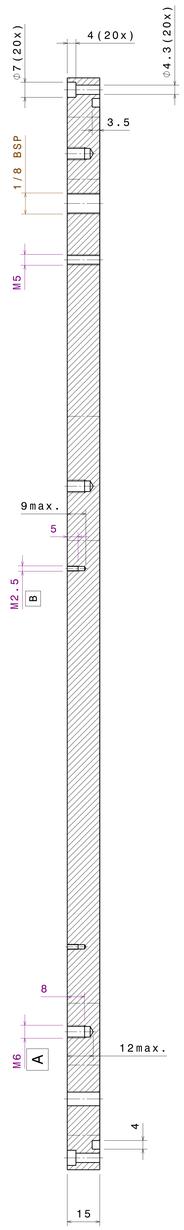

Section view A-A

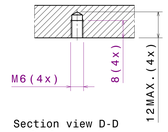

Section view D-D
Scale: 1:1

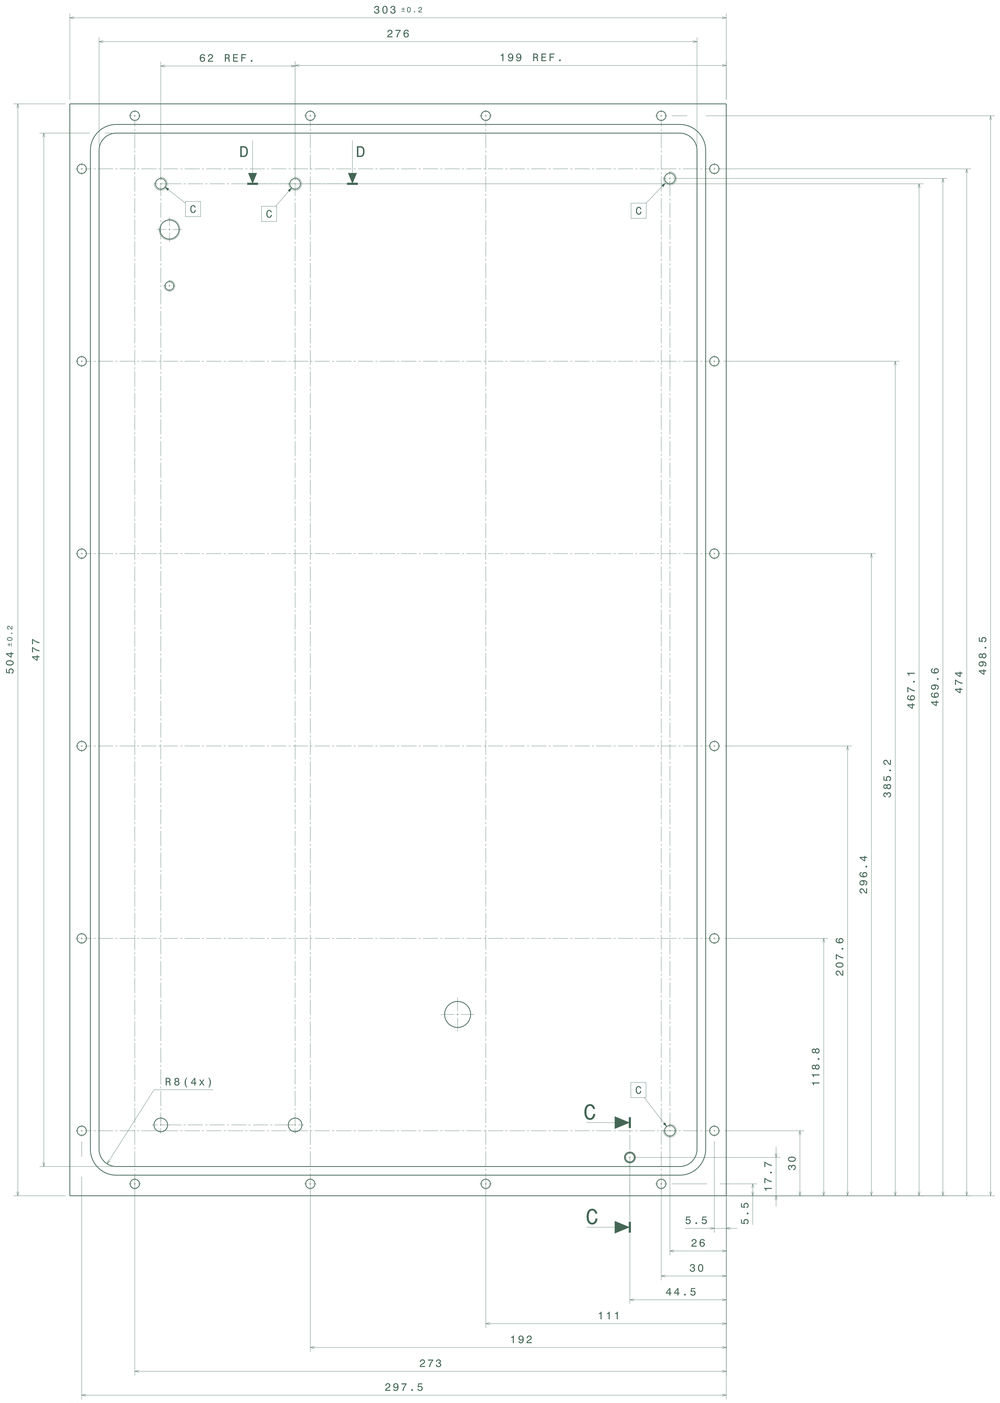

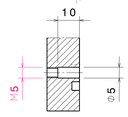

Section view C-C
Scale: 1:1

AS BUILT

General tolerances unless otherwise stated according to :ISO-2768-mK Geometrical tolerances unless otherwise stated according to:ISO-8015-E Roughness unless otherwise stated according to :ISO-1302		Material:	PVC (zwart)
Project: R&D Spark Chamber	Units: mm	Date: 10/02/2010	Revision: A
Library: Large Spark Chamber	Size: A0	Engineer: A. Korporaal	
Name: Endplate Front Large		Checked: A. Korporaal	
		Item number: AA0247	Status: Released
NIKHEF National Institute for Subatomic Physics, Science Park 105, 1098XG Amsterdam		Nikhef number: 40091-ME-00147	

This drawing may not be used for commercial purposes without written authorisation.